



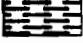

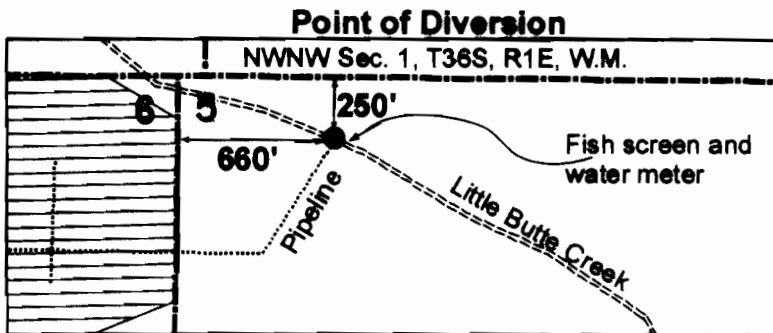


**Claim of Beneficial Use Map**  
 Deborah Lilian Thompson (Gadberry)  
 Application T-8829  
 T 35 S, R 1 E, Sec 31, W.M.  
 T 36 S, R 1 E, Sec 6, W.M.

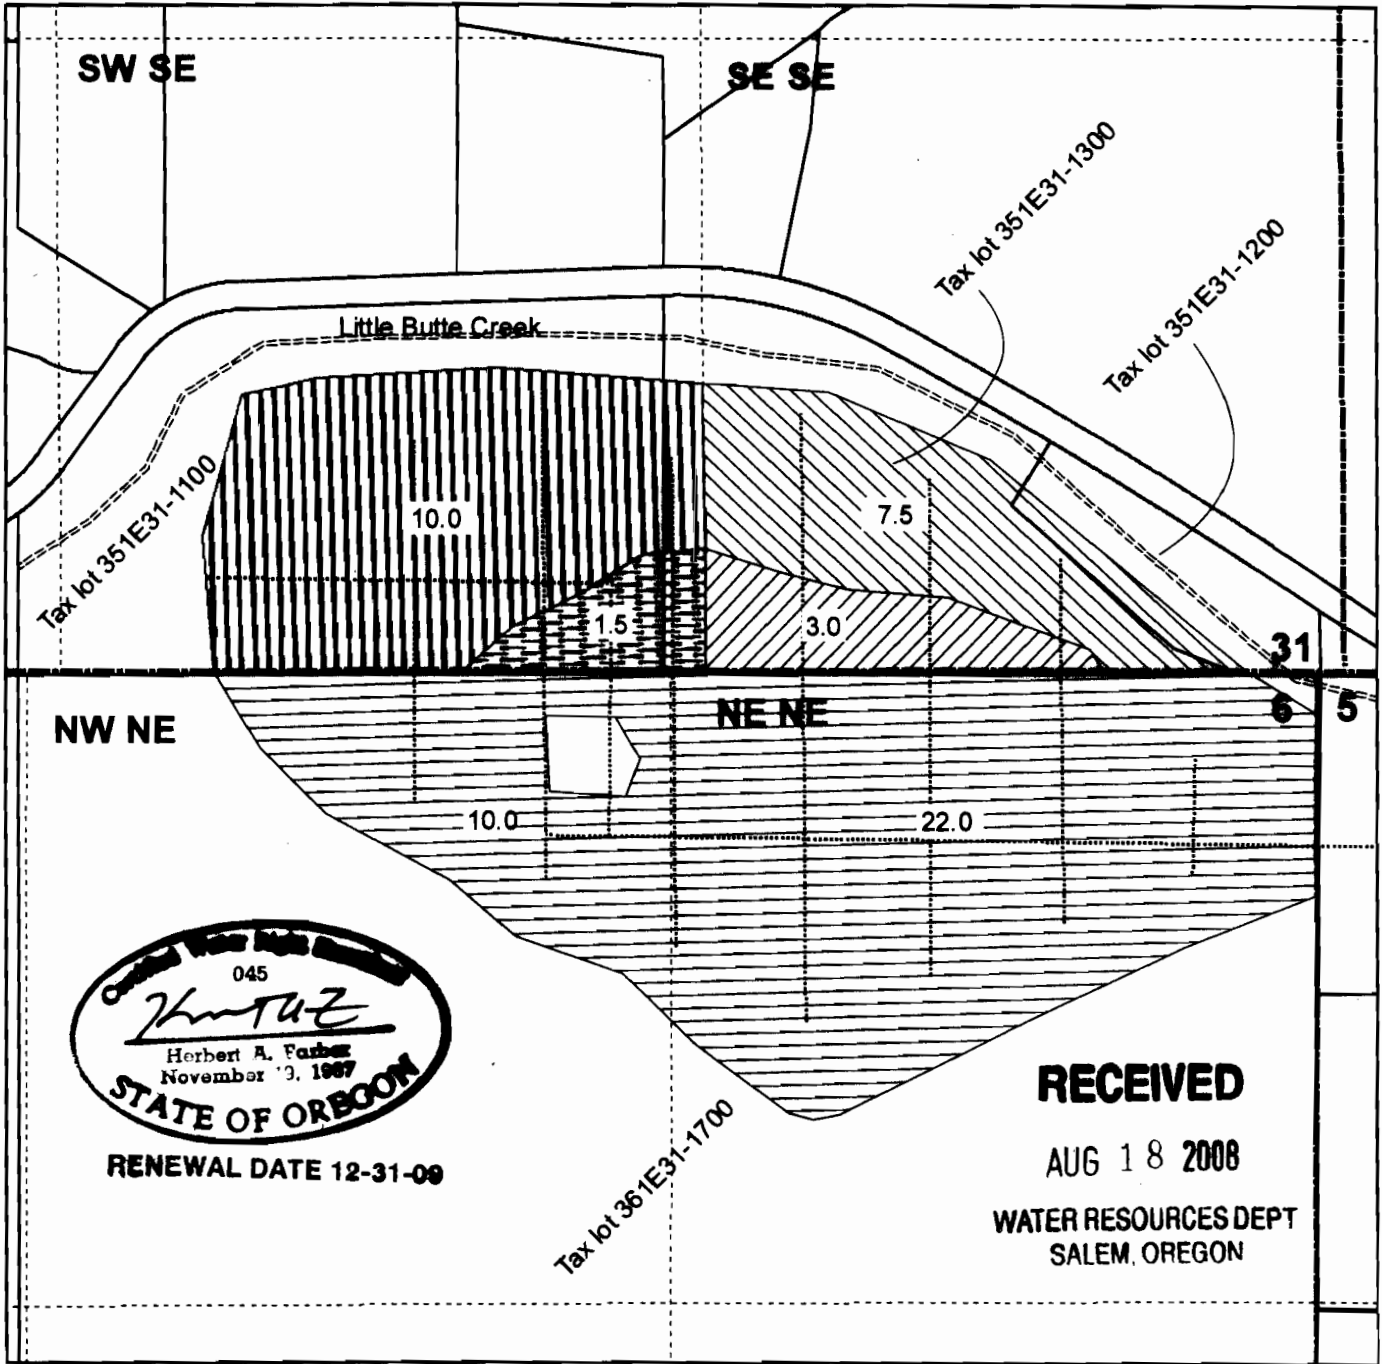


**Legend**

-  C17163 1885
-  C17163 1908
-  c17164 1885
-  C17170 1885
-  C17170 1908



This map is not intended to provide legal dimensions or locations of property ownership lines.

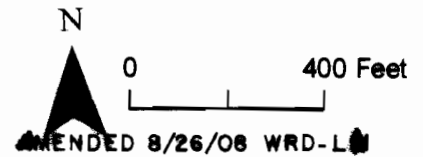

**FARBER**  
 SURVEYING

PO Box 5286  
 Central Point, Oregon 97502  
 Phone 541-664-5599  
 Fax 541-664-5603  
 Email [hfarber@charter.net](mailto:hfarber@charter.net)

Farber & Sons, Inc.  
 431 Oak Street  
 Central Point, Oregon  
 Fax 541-664-5603  
 Tax ID: 93-1057173