


T 37 S, R 2 W, W.M. **RECEIVED**
Section 32
Jackson County, Oregon

FEB - 1 1996
 SEP 20 1995
 WATER RESOURCES DEPT.
 SALEM, OREGON
RECEIVED

FINAL PROOF SURVEY
 UNDER

Application G - 12406 Permit G-11409

FEB - 1 1996

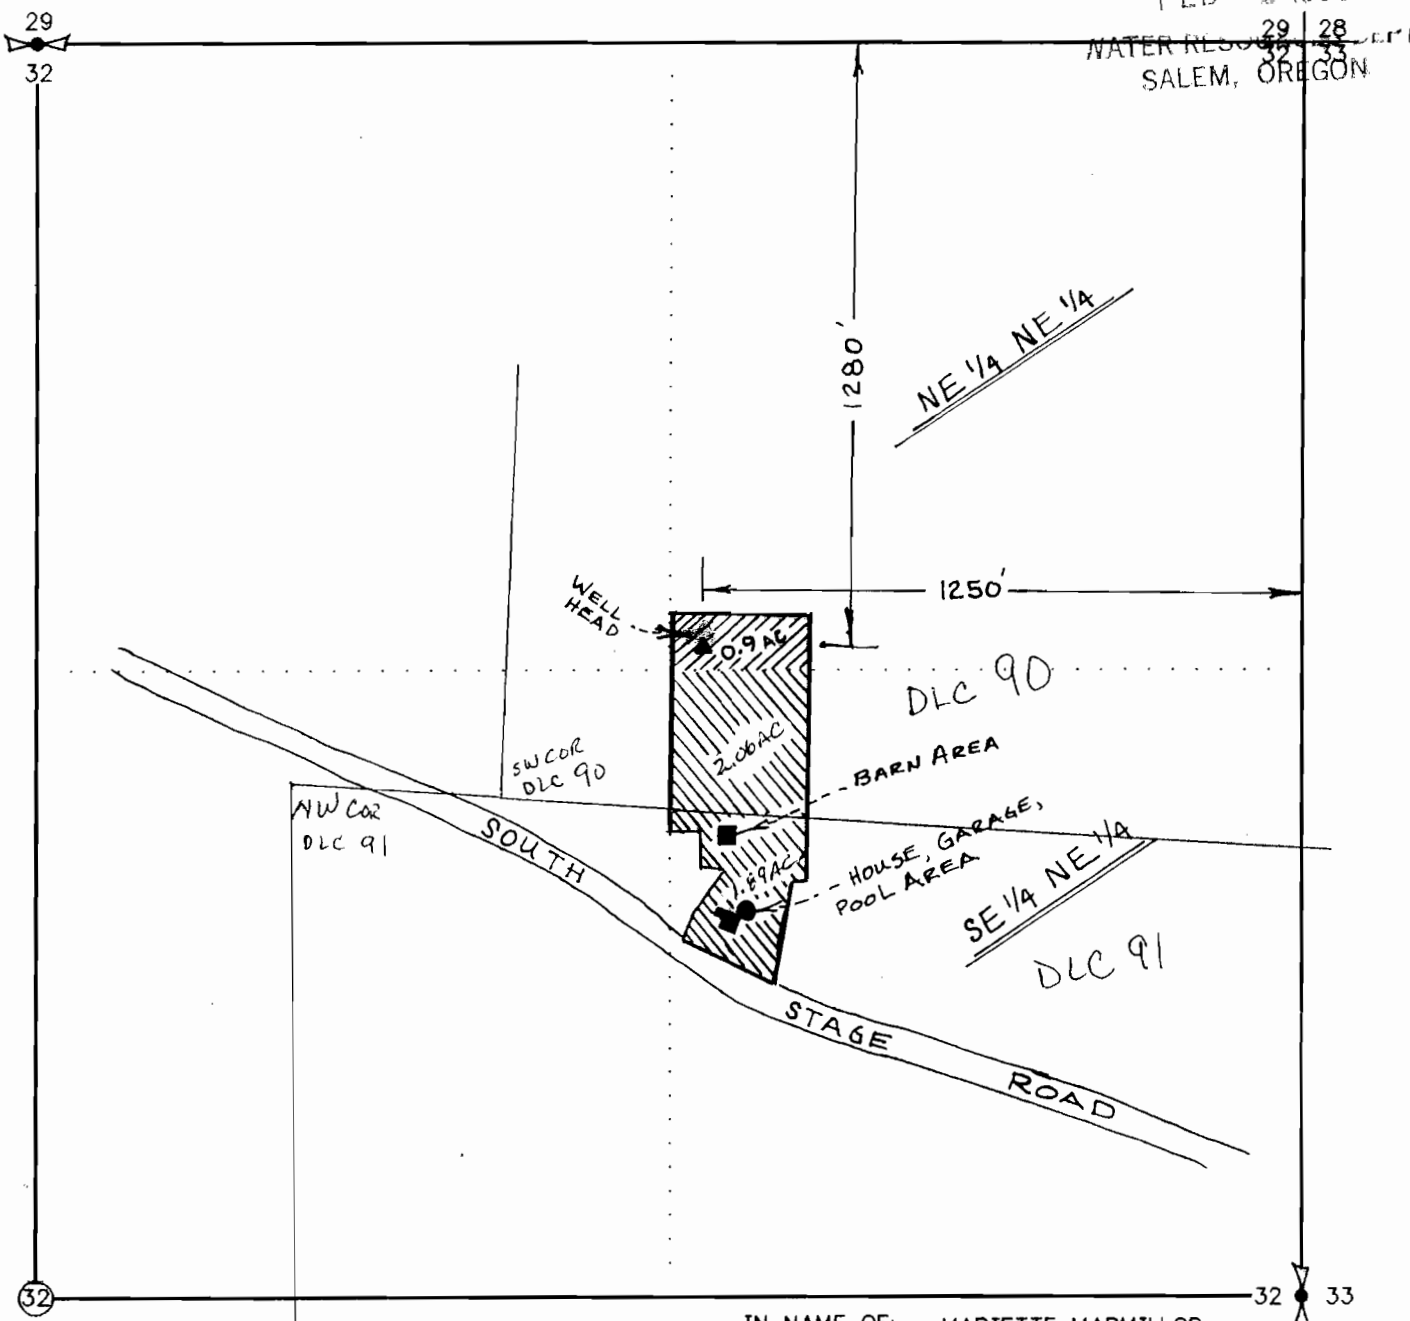

SCALE 1" = 400'

Certified Water Right Examiner
 013
Richard L. Bath
 Richard L. Bath
 Nov. 19, 1987
 STATE OF OREGON
 Exp. 12-31-95

IN NAME OF: MARIETTE MARMILLOD
 755 E. CALIFORNIA ST.
 JACKSONVILLE, OR. 97530

Surveyed August 28, 1995
 by *Richard L. Bath*

Richard L. Bath
 CWRE No. 013

Amended by WED staff to show DLCs 6-11-08 HNG