



T.4S., R.4W., W.M.

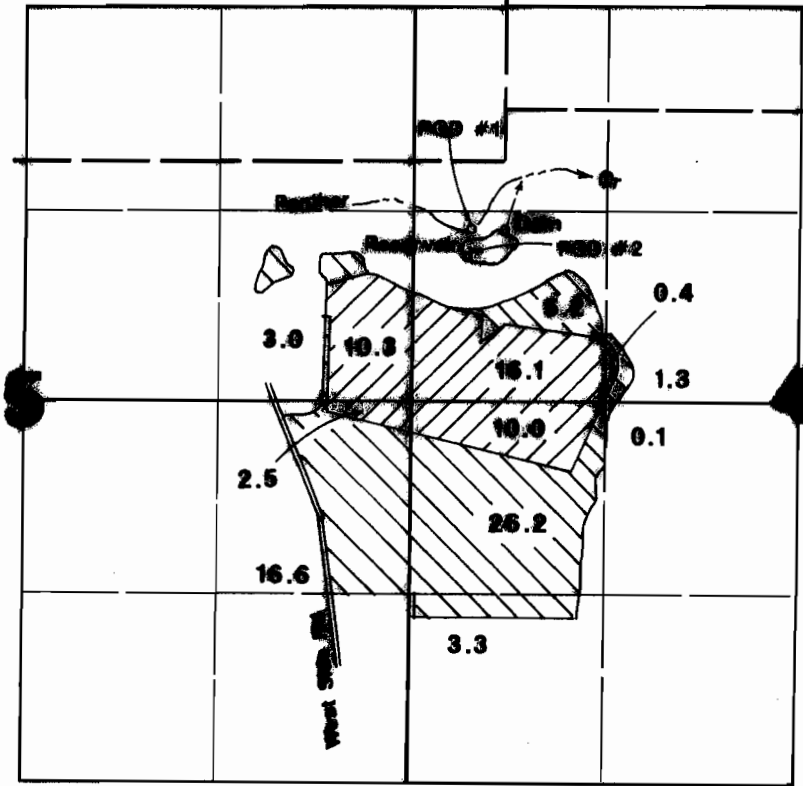

1" = 1320'

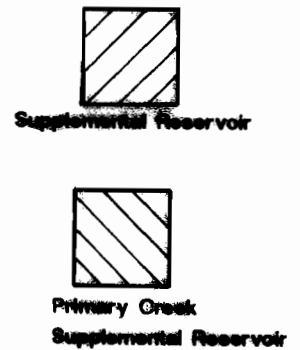

Dam located 1170'N & 630'E from W $\frac{1}{4}$ corner Section 4.
 POD #1 located 1200'N & 370'E from W $\frac{1}{4}$ corner Section 4.
 POD #2 located 1000'N & 650'E from W $\frac{1}{4}$ corner Section 4.

RECEIVED

DEC - 9 1994

WATER RESOURCES DEPT.
 SALEM, OREGON

Final Proof Survey

Application #: R-70282 Permit #: R-11467
 70283 81460

In Name Of

Eugene Bernards

Surveyed on November 15, 1994 by JM Schuette

THIS MAP WAS PREPARED FOR THE PURPOSE OF
 RECORDING THE LOCATION OF PROPERTY
 OWNERSHIP LINES.

