


RECORDED

SEP 1995

T.7 S. R.1 E., W.M.

WATER RESOURCES DEPT
STATE OF OREGON

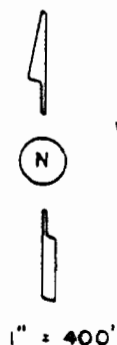

DRIFT CR. RD.

LEWIS DLC 38

CO. RD. NO. 784

NE COR
D.P. LEWIS
DLC 38

LEWIS
CEMETERY

30 29
31 32

1/4 COR

FINAL PROOF SURVEY

FOR


Application R-70467
Application S-70468

Permit R-11420
Permit 51376

ROBERTA J. CLAYTON

Surveyed on June 26, 1990 & August 16, 1995

THIS MAP WAS PREPARED FOR THE
PURPOSE OF IDENTIFYING THE LOCA-
TION OF A WATER RIGHT ONLY AND IS
NOT INTENDED TO PROVIDE LEGAL
DIMENSIONS OR LOCATION OF PROPER-
TY OWNERSHIP LINES.

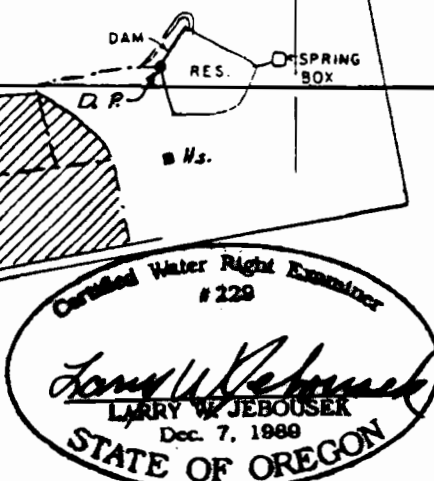

Diversion Point loc: 1,425' S & 2,000' W from NE Corner D.P. Lewis DLC 38