


T.7 S. R.1 E., W.M.

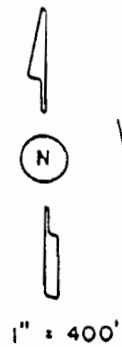

DRIFT CR. RD.

LEWIS DLC 38

NE COR
DP LEWIS
DLC 38

LEWIS
CEMETERY

CO. RD. NO. 784

30 29
31 32

1/4 COR

FINAL PROOF SURVEY
FOR




Application R-70467
Application S-70468

Permit R-11420
Permit 51376

ROBERTA J. CLAYTON

Surveyed on June 26, 1990 & August 16, 1995

THIS MAP WAS PREPARED FOR THE
PURPOSE OF IDENTIFYING THE LOCA-
TION OF A WATER RIGHT ONLY AND IS
NOT INTENDED TO PROVIDE LEGAL
DIMENSIONS OR LOCATION OF PROPER-
TY OWNERSHIP LINES.

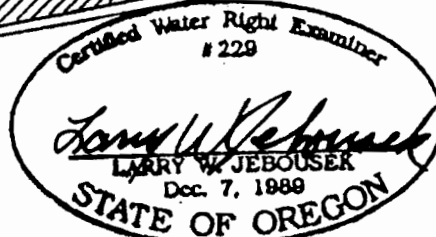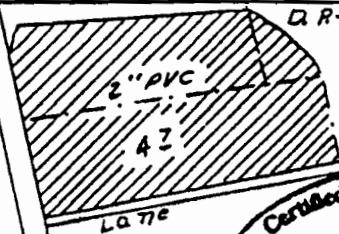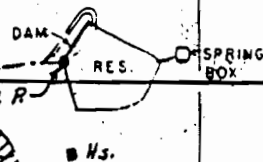

Diversion Point loc: 1,425' S & 2,000' W from NE Corner D.P. Lewis DLC 38