



T.9S.R.1E.W.M.

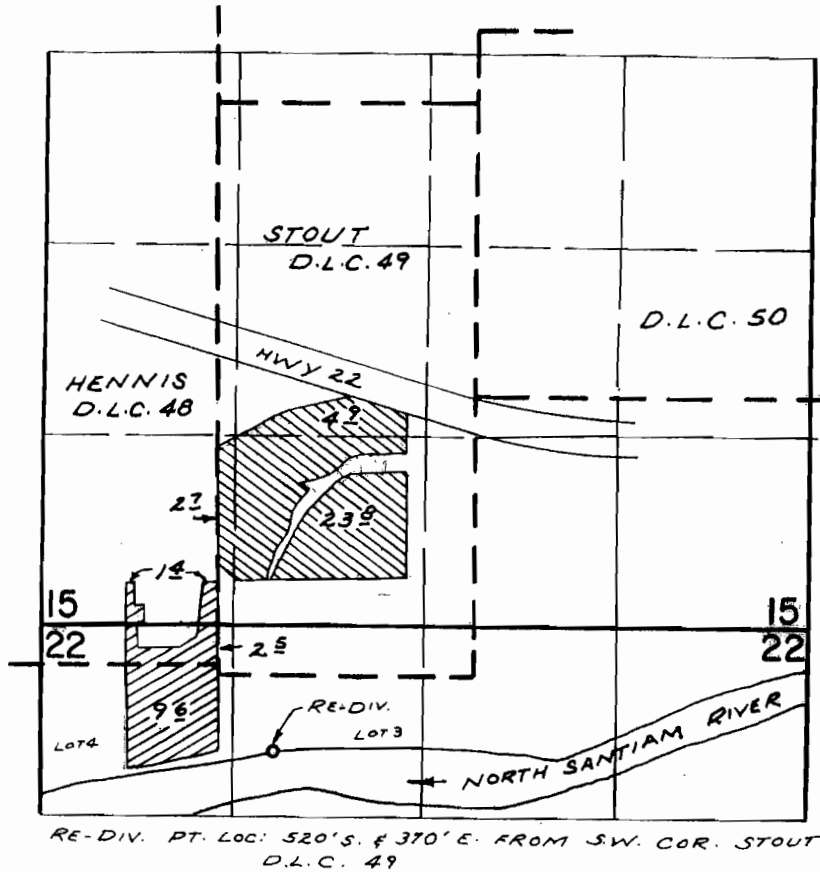

FINAL PROOF SURVEY UNDER

Application No. 41909 43423 Permit No. 31373 32464 
IN NAME OF

ROBERT & RICHARD KOENIG

Surveyed Nov. 7, 1972, by R. MURKIN