


T.9S.,R.1E.,W.M.

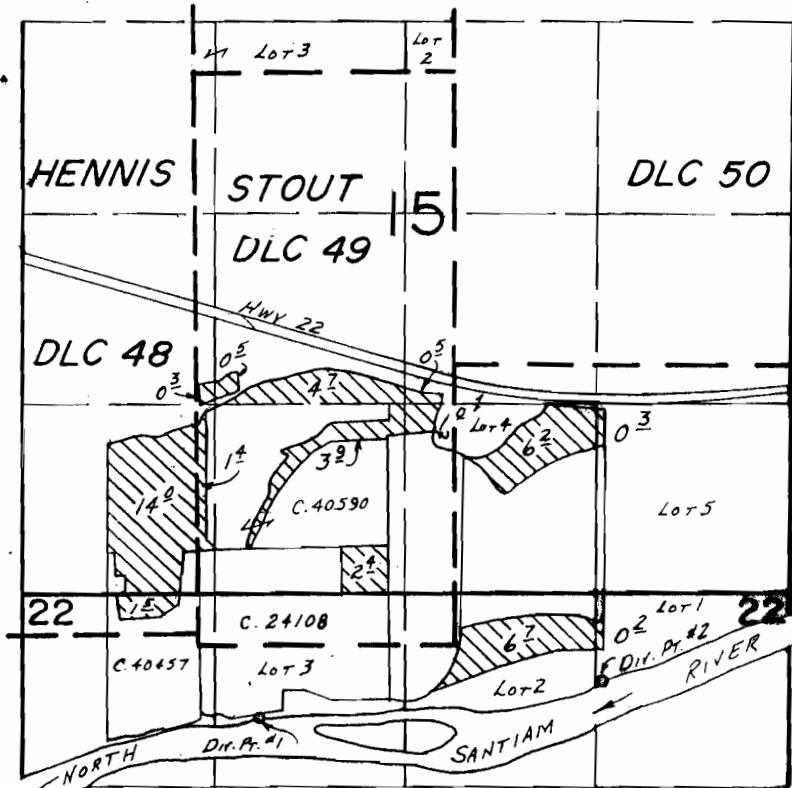

Dir. Pts. Loc.: #1. 520'S. & 400'E., #2. 250'S. & 2770'E., BOTH FROM SW COR. STOUT DLC 49.

SCALE: 1"=1320'

FINAL PROOF SURVEY UNDER

Transfer No. 5201

Application No. 64841... Permit No. 47553.....

IN NAME OF

RICHARD P & DIANE KOENIG.....

Surveyed July 31... 19.84, by B.W. BISHOP.....