

SECTION 12, T.2S., R.1W., W.M.  
WASHINGTON COUNTY OREGON

RECEIVED

SEP 25 1995

WATER RESOURCES DEPT.  
SALEM, OREGON



SCALE: 1" = 200'

MAP BASE:  
ASSESSORS MAP  
1994 WAC PHOTO

N.W. 1/4, S.E. 1/4 0.1 Ac.

S.W. 1/4, S.E. 1/4 0.5 Ac.

T.L. 401

D.E.

AVENUE

CLARK

72.89

NEBULLOS

S.W. KABLE LANE

T.L. 200


S.W.

2" - DIA PVC

WELL

1090'

SOUTH 1/4 COR.  
440'

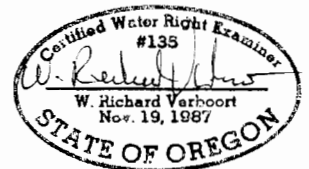

PREPARATION OF THIS MAP IS FOR THE  
PURPOSE OF IDENTIFYING THE LOCATION OF  
THE WATER RIGHT ONLY. THERE IS NO INTENT  
TO PROVIDE DIMENSIONS OR LOCATION OF  
PROPERTY OWNERSHIP LINES.

FINAL PROOF SURVEY  
FOR  
APPLICATION G-12536 PERMIT G-11340  
SURVEYED SEPTEMBER 18, 1995

**VERBOORT ENGINEERING**  
AGRICULTURE • CIVIL • WATER RESOURCES  
HILLSBORO, OREGON

	by	date
designed	WRV	9/19/95
drawn	JUR	9/19/95
checked	WRV	9/19/95
drawing no.	95-B-12	
sheet no.	1/1	

**PACIFIC REALTY ASSOCIATES**  
15350 S.W. SEQUOIA PARKWAY  
SUITE 300  
PORTLAND, OREGON 97224