


SECTION 12, T.2S., R.1W., W.M.  
WASHINGTON COUNTY, OREGON

SCALE: 1" = 200'  
MAP BASE:  
ASSESSORS MAP  
1994 WAC PHOTO

LANDSCAPE WATER  
FEATURE (POND)

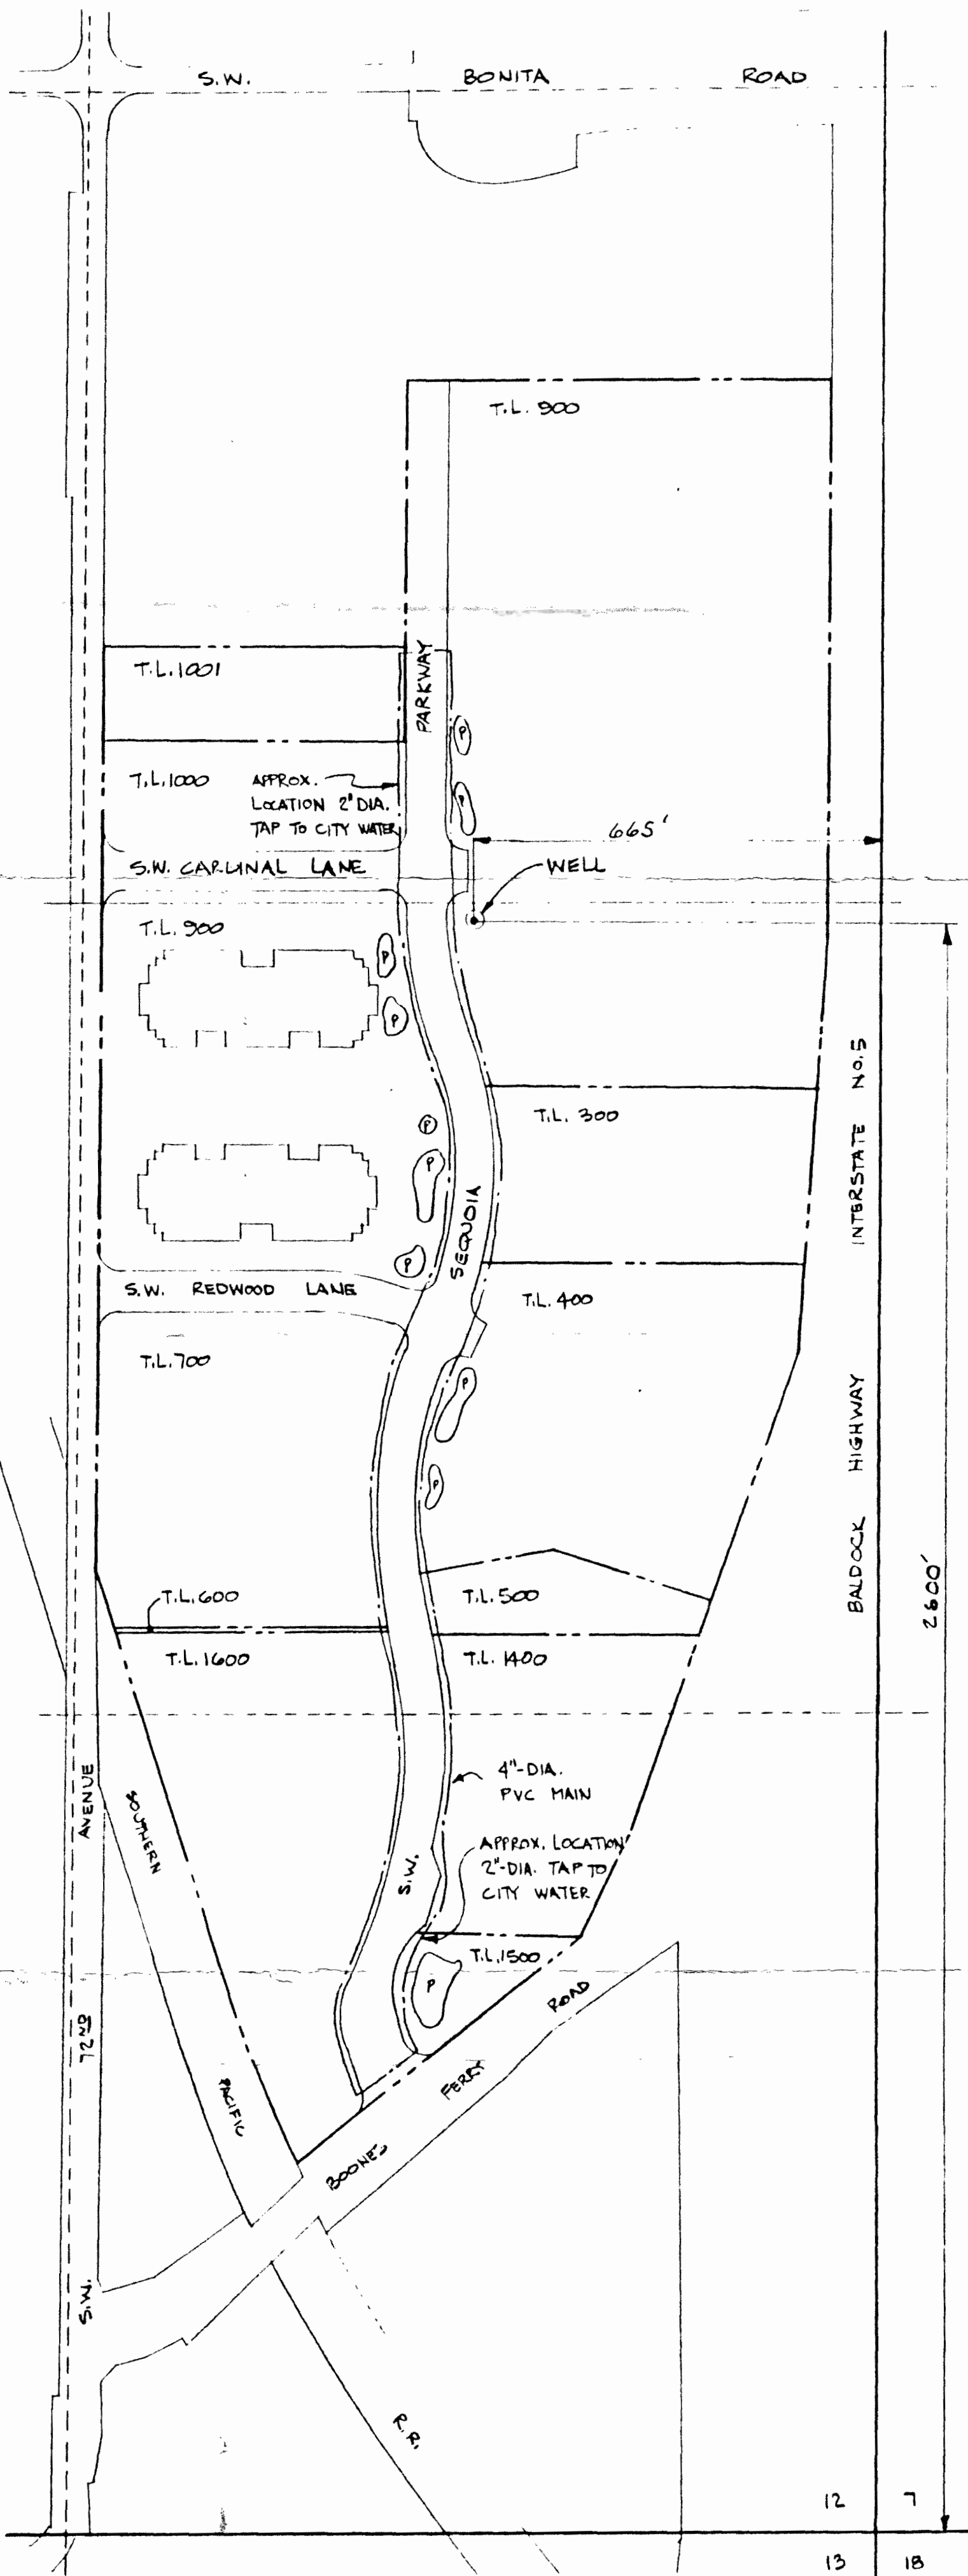

12 7  
13 18

FINAL PROOF SURVEY  
FOR  
APPLICATION G-12122 PERMIT G-11155  
SURVEYED 9/18/95

**VERBOORT ENGINEERING**  
AGRICULTURE · CIVIL · WATER RESOURCES  
HILLSBORO, OREGON

by date  
designed WRV 9/18/95  
drawn JER 9/18/95  
checked WRV 9/18/95  
drawing no. 95-C-02  
sheet no. 1/1



PACIFIC REALTY ASSOCIATES  
15350 S.W. SEQUOIA PARKWAY # 500  
PORTLAND, OREGON 97224