


FINAL PROOF SURVEY MAP
T25S, R6W, WM
SCALE 1" = 1320'

DOUGLAS COUNTY

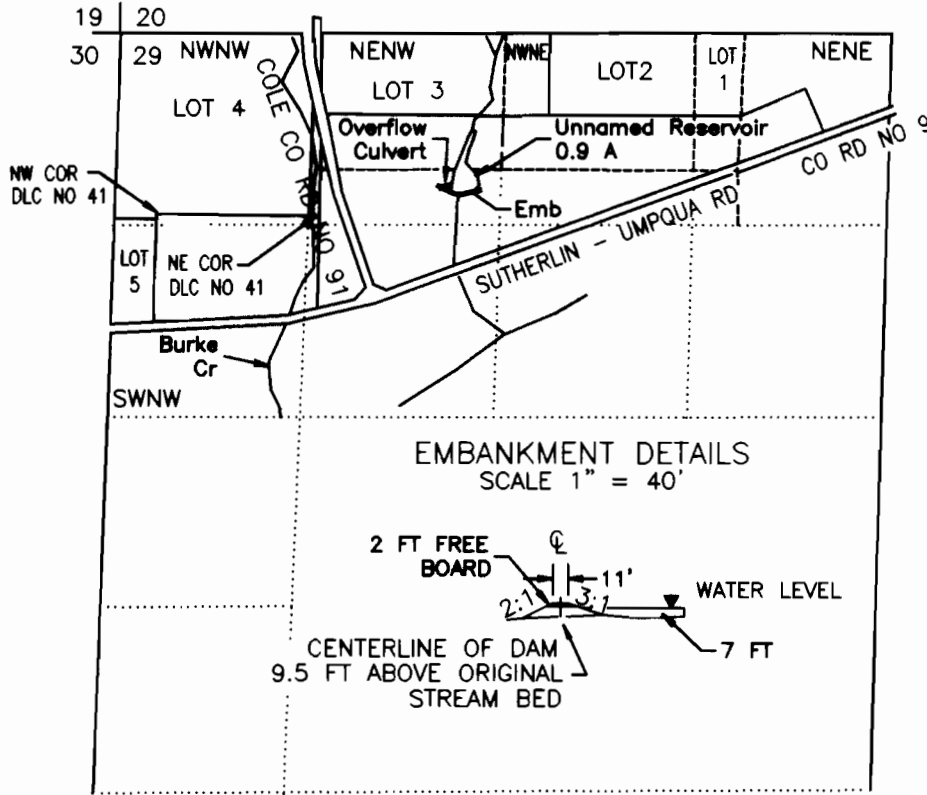

RECEIVED

SEP 28 1999

WATER RESOURCES DEPT.
SALEM, OREGON

POD IS 660 FT S AND 2410 FT E FROM NW COR SEC 29

FINAL PROOF SURVEY
UNDER

Application No. R-72985 Permit No. R-11612

IN NAME OF

Robert A. or Ethel M. Poage

Surveyed July 15, 1999 by M E Farr

THIS IS A LOCATION MAP FOR A FINAL PROOF SURVEY BY ROBERT A or ETHEL M POAGE. THIS MAP IS FOR THE PURPOSE OF IDENTIFYING THE LOCATION OF THE WATER RIGHT ONLY AND IS NOT INTENDED TO PROVIDE LEGAL DIMENSIONS OR LOCATIONS OF PROPERTY OWNERSHIP LINES.

MAP PREPARED FOR:
ROBERT A or ETHEL M POAGE
428 NW GARDEN VALLEY BLVD
ROSEBURG, OR 97470

MAP PREPARED BY:
MAURICE E FARR, CWRE
395 NE KIRBY AVENUE
ROSEBURG, OR 97470

