


31 | 32  
6 | 5

**FINAL PROOF SURVEY**  
for  
**ROBBINS DAM AND RESERVOIR**  
**POLK COUNTY, OREGON**

Under

Application No. R - 81274, Permit No. R - 12149

Section 5, Township 9 South, Range 5 West, W.M.

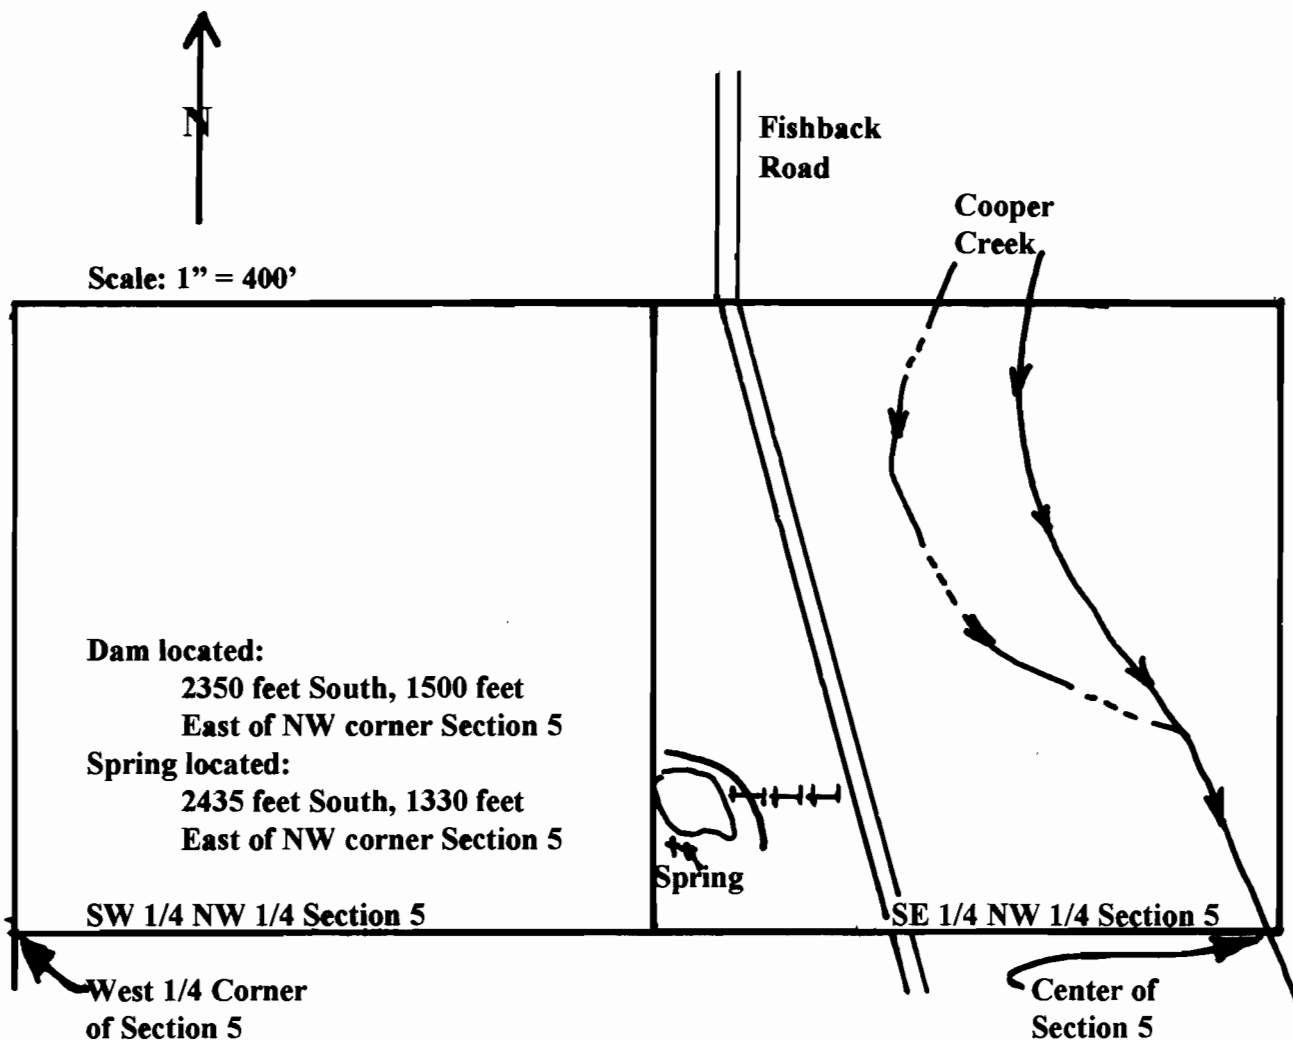

**RECEIVED**

JAN 17 1998

WATER RESOURCES DEPT  
SALEM, OREGON

This map was prepared for the purpose of identifying the location of a water right only and is not intended to provide legal ownership lines.