


T. 40 S., R. 3 E., W.M.

DIVERSION IS LOCATED
1625 FT EAST AND
445 FT SOUTH OF THE
NW COR OF SECTION 21

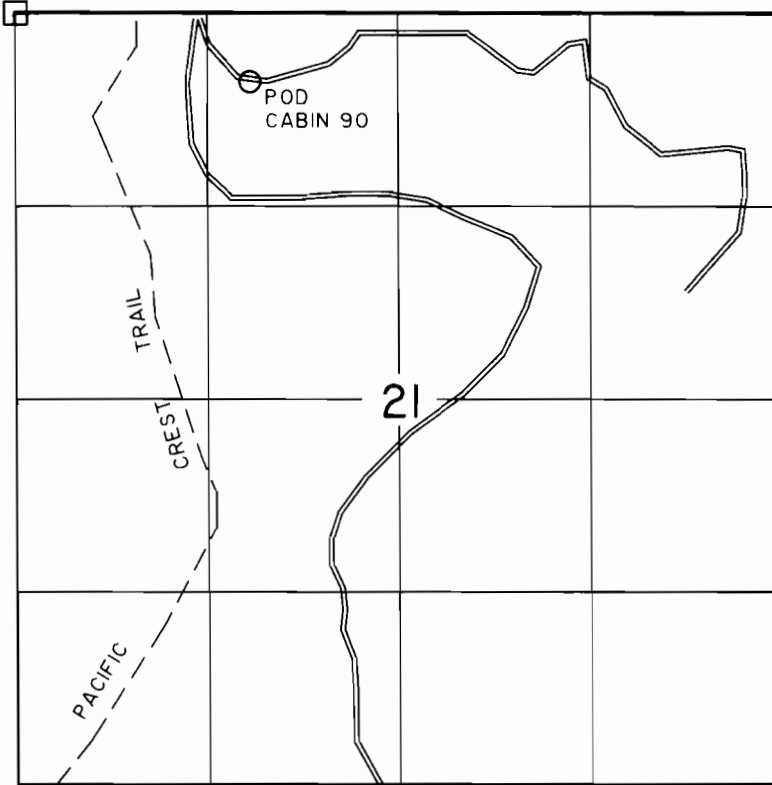

1" = 1320'


CLAIM OF BENEFICIAL USE MAP

IN NAME OF

UNITED STATES BUREAU OF LAND MANAGEMENT

APPLICATION NO. S-83933

PERMIT NO. 53565

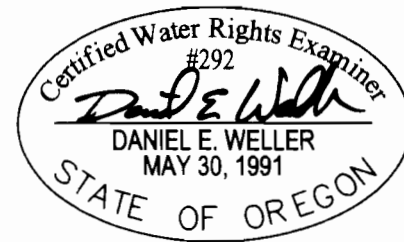

EXPIRES: JUNE 30, 2004

SURVEYED: MAY 9, 2001

THE PURPOSE OF THIS MAP IS FOR IDENTIFYING THE LOCATION OF THE WATER RIGHT ONLY AND IS NOT INTENDED TO PROVIDE LEGAL DIMENSIONS OR LOCATION OF PROPERTY OWNERSHIP LINES.

BLM PROJECT NO.

U.S. BUREAU OF LAND MANAGEMENT-OSO
BRANCH OF CADASTRAL SURVEY
DWG: CABIN90

EXECUTED BY:
DANIEL E. WELLER, PLS, CWRE #292
P.O. BOX 10226
EUGENE, OREGON 97440