



T. 6S., R. 38E., W.M.

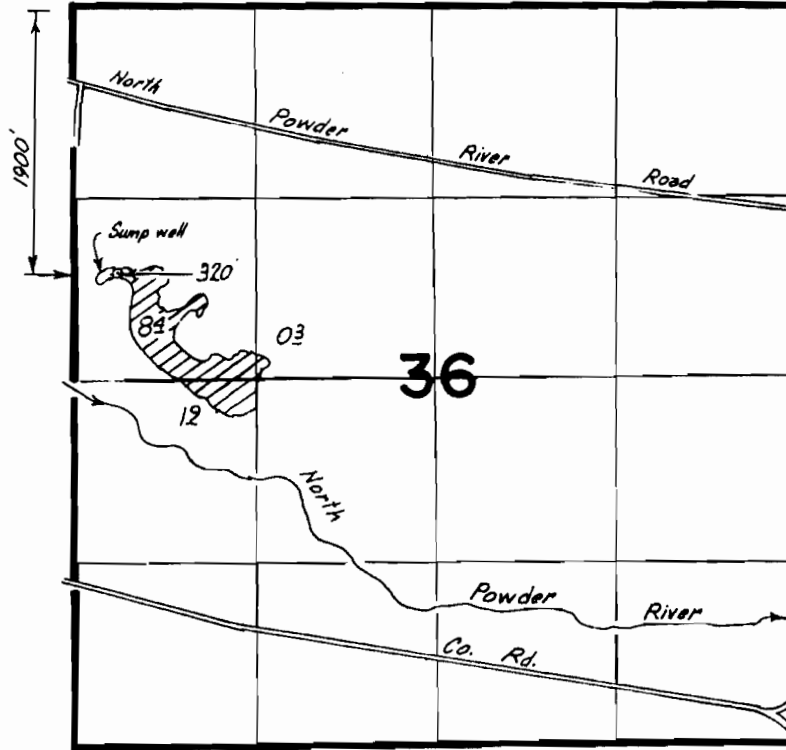

FINAL PROOF SURVEY UNDER

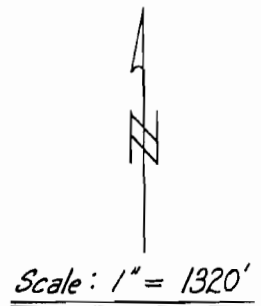

Application No. G-8600 Permit No. G-7978
IN NAME OF

LULA A. CANTRELL & WILLIAM J. CANTRELL

Surveyed 6-4 1987, by Vern Church