



T. 30 S., R. 6 W., W.M.

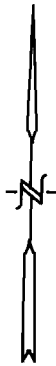

SCALE: 1" = 400'

THE PURPOSE OF THIS MAP IS TO IDENTIFY THE LOCATION OF THE WATER RIGHT, IT IS NOT INTENDED TO PROVIDE INFORMATION RELATIVE TO THE LOCATION OF PROPERTY OWNERSHIP BOUNDARY LINES.

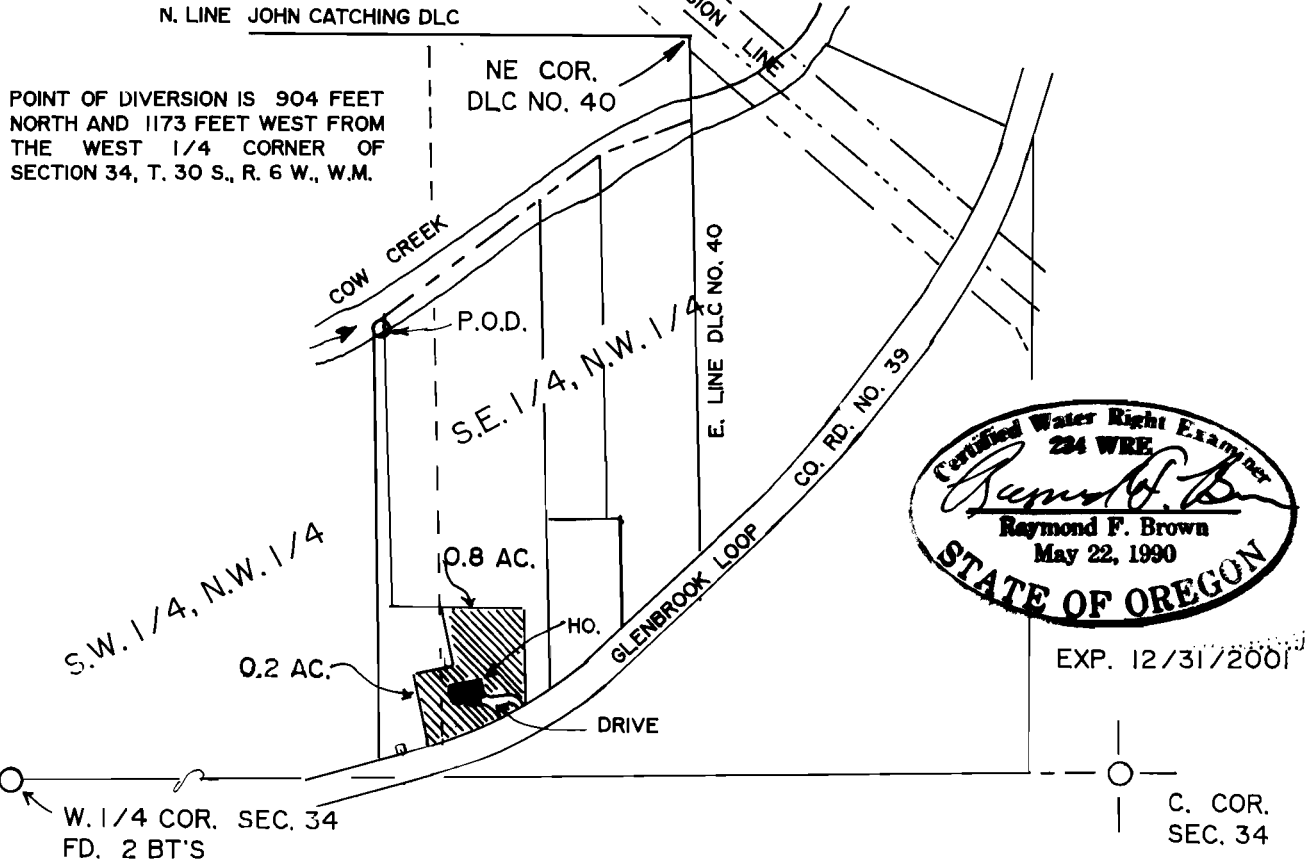

FINAL PROOF SURVEY
UNDER

Application No. S-80526 Permit No. 52571

IN NAME OF

BEVERLY WAGONER

Surveyed SEPT. 13, 2000 by R.F. BROWN

RECEIVED

SEP 29

WAT. RIGHTS
ALF4