


# T. 9 S. R. 1 W. W.M.

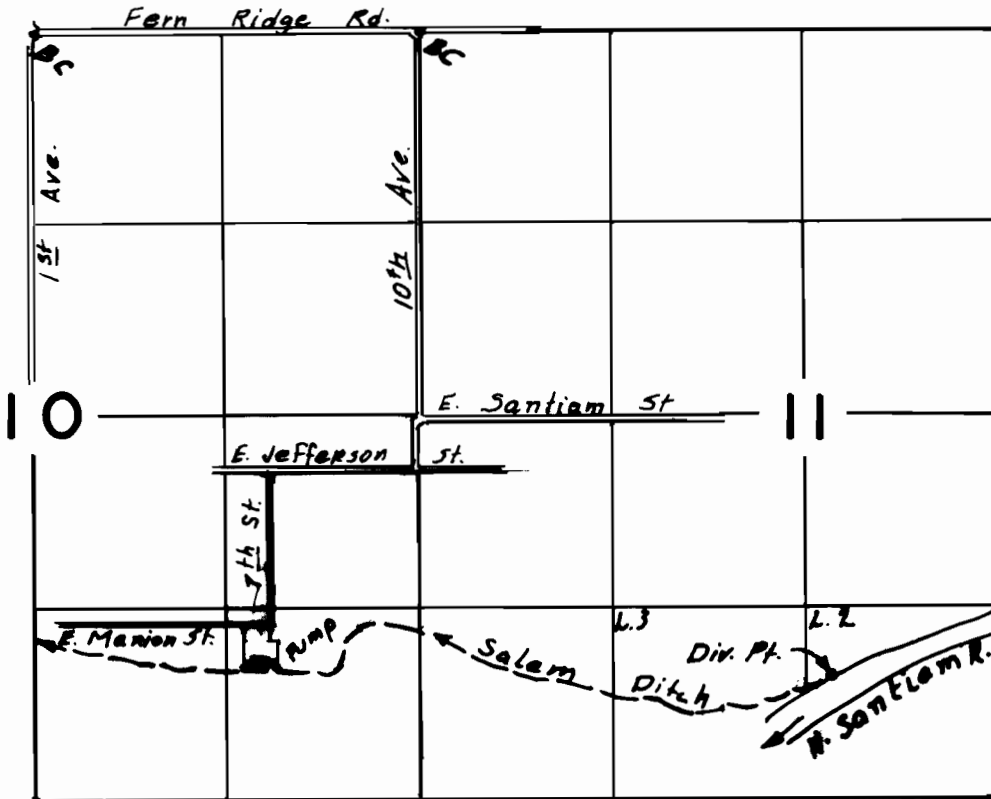

Div. Pt. loc. 1800' S & 2830' E from W 1/4 Cor. Sec. 11  
 Ditch Pump loc. 1750' S & 990' W " " " " "

**RECEIVED**

SEP 14 1999


WATER RESOURCES DEPT.  
 SALEM, OREGON

## FINAL PROOF SURVEY UNDER

Application No. R-72409 Permit No. R-11557  
 IN NAME OF

**DAVID & BEVERLY THOMPSON**

Surveyed Feb. 14, 1992, by .....  
Aug. 13, 1999

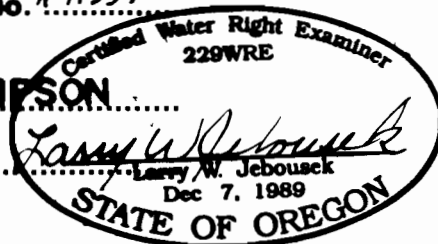

THIS MAP WAS PREPARED FOR THE PURPOSE OF IDENTIFYING THE LOCATION OF A WATER RIGHT ONLY AND IS NOT INTENDED TO PROVIDE LEGAL DIMENSIONS OR LOCATION OF PROPERTY OWNERSHIP LINES.

Marion Co. Survey 1992 WAC Photo