


T.36 S. R.07 W. SEC. 2

WM RECEIVED

PREPARED BY:
JONATHAN C. SPERO C.W.R.E. 123
1002 KINCAID RD./P.O. BOX 16
WILLIAMS, OREGON 97544
PH. (541) 846-6845

SEP 21 1999

WATER RESOURCES DEPT.
SALEM, OREGON

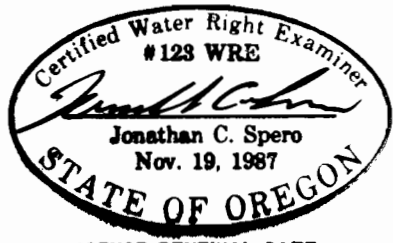

LOT 16 OF
FERRY PARK ESTATES




● FOUND 5/8" IRON ROD PER
FERRY PARK EST. SUB.

SCALE: 1" = 400'

IRON PIPE
2 1/4

②

BURIED 1 1/2"
PVC PIPELINE

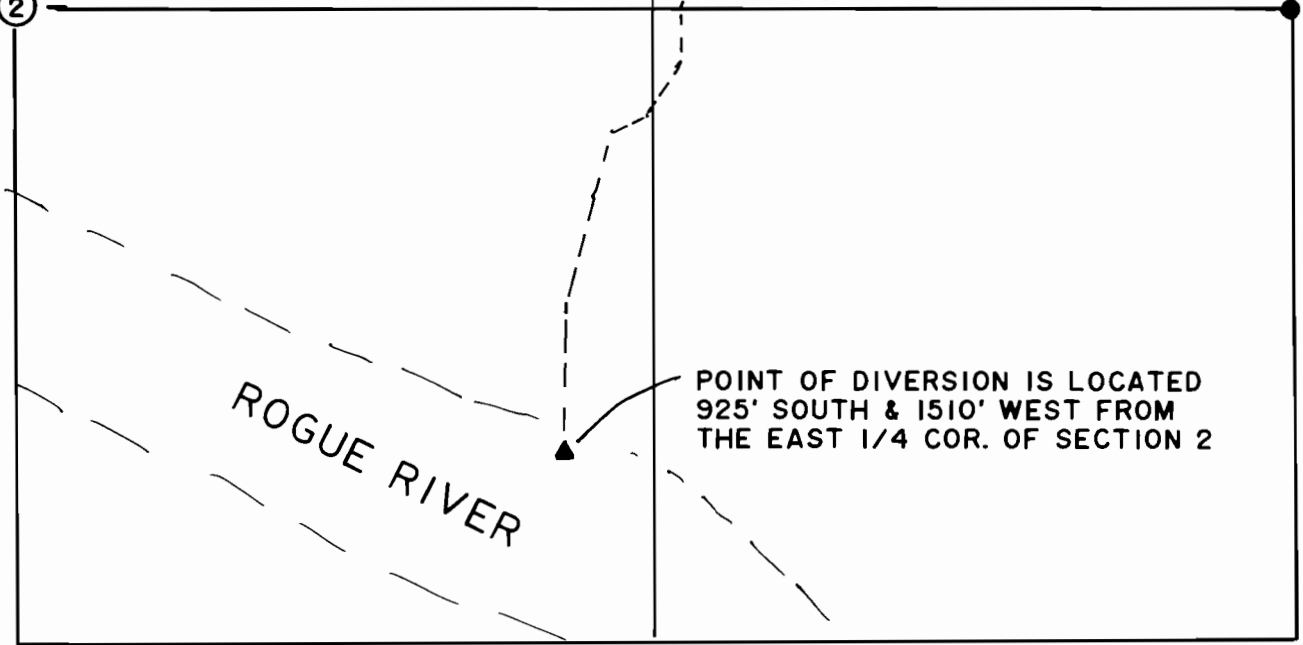

POINT OF DIVERSION IS LOCATED
925' SOUTH & 1510' WEST FROM
THE EAST 1/4 COR. OF SECTION 2

FINAL PROOF SURVEY

UNDER

APPLICATION No. S-72046

PERMIT No. 51701

IN NAME OF

LOUIS SCAPARO

SURVEYED SEPTEMBER 9, 1999 BY:  JONATHAN C. SPERO