


Tax Lot No. TL500 23 12 6
 Section 1 Township 23 Range 13 W.M.
 Section 6 Township 23 Range 12 W.M.
 Coos County

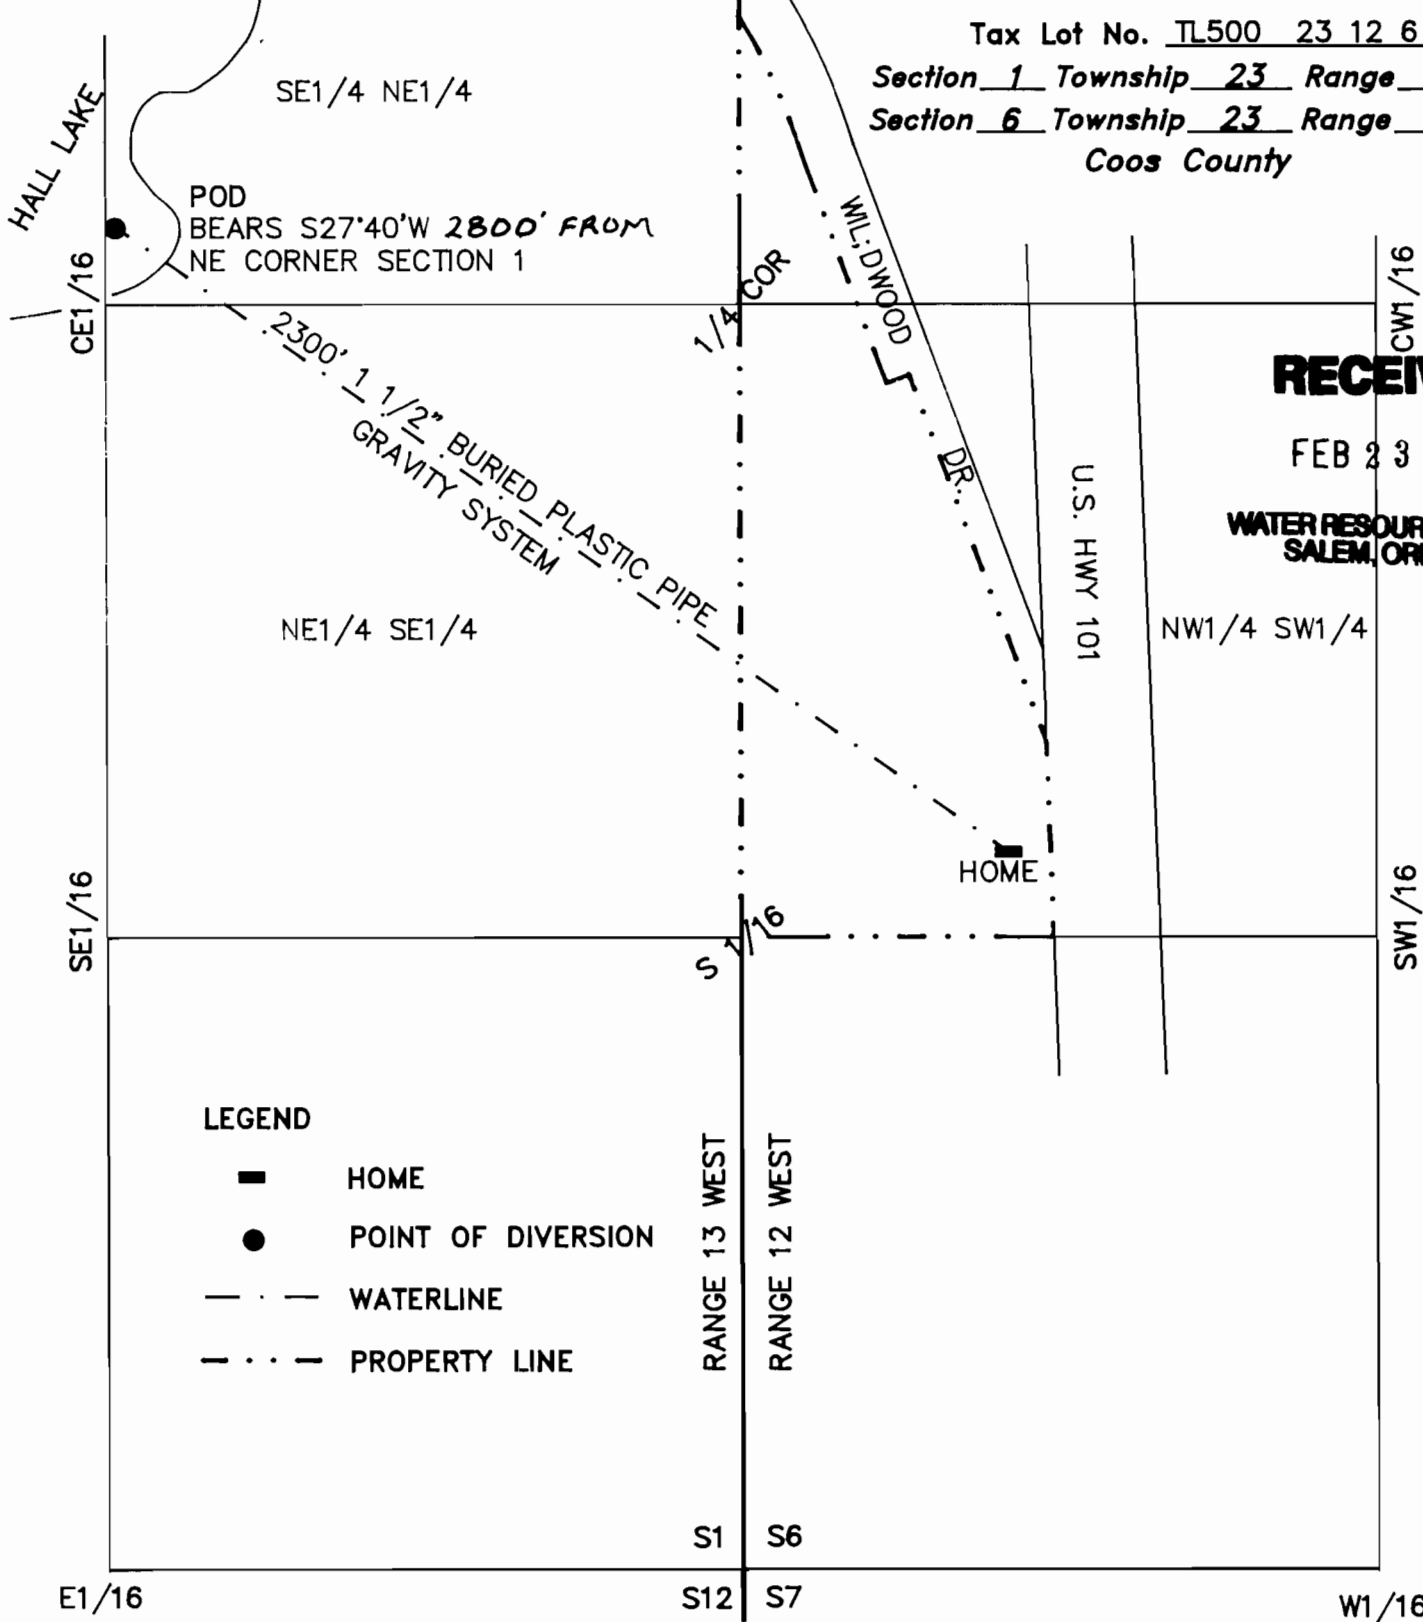

RECEIVED

FEB 23 2000

WATER RESOURCES DEPT.
 SALEM, OREGON

LEGEND

- HOME
- POINT OF DIVERSION
- . - WATERLINE
- . . - PROPERTY LINE

Scale 1" = 400'

EXAMINERS DISCLAIMER STATEMENT

The preparation of this map was for the purpose of identifying the location of the Water Right only and has no intent to provide dimensions or location of property ownership lines.

FINAL PROOF SURVEY
 IN THE NAME OF
Charlie & Laurie Schuttpelz

Certified Water Right Examiner
 #142
 Harvey Wilcox
 Nov. 19, 1987
 STATE OF OREGON
 RENEWAL 6/30/00

Surveyed on 11/17/99 by H.A. Wilcox

Application No. S-72149
 Permit No. 52510