


T. 26 S., R. 3 W., W.M.

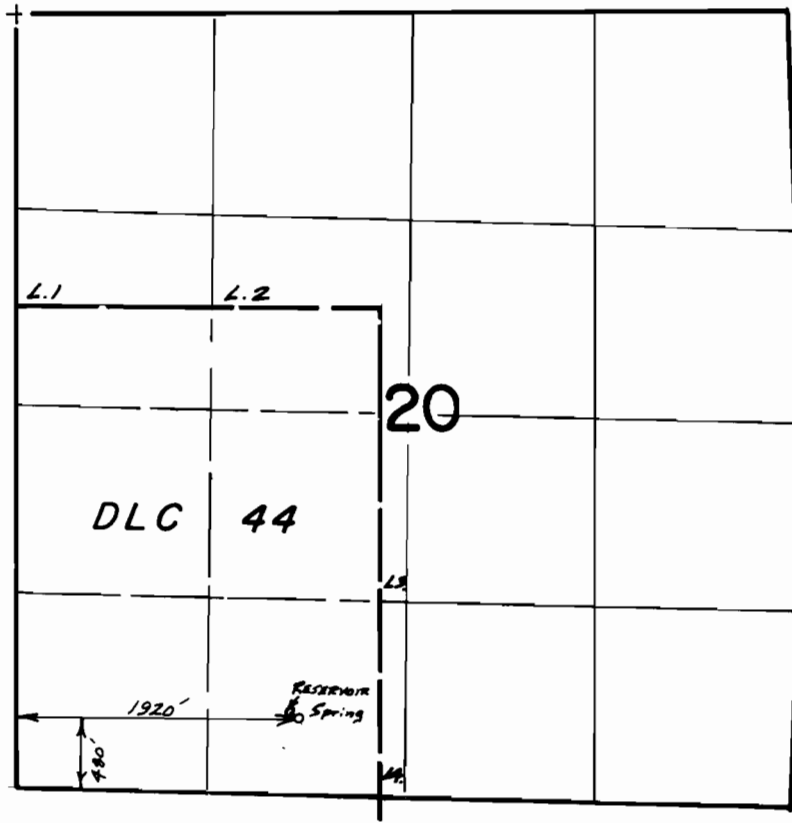

Scale : 1"=1320'

**FINAL PROOF SURVEY
UNDER**

R-58850 R-7997
Application No. 58851. Permit No. 44695....
IN NAME OF

.....Frances..M.(Manning).Livingston...

Surveyed Oct. 22, 1991., by B.S. James.....