


NE 1/4 OF NW 1/4 OF SECTION 27
T1S, R4E of the WM
CLACKAMAS COUNTY, OREGON

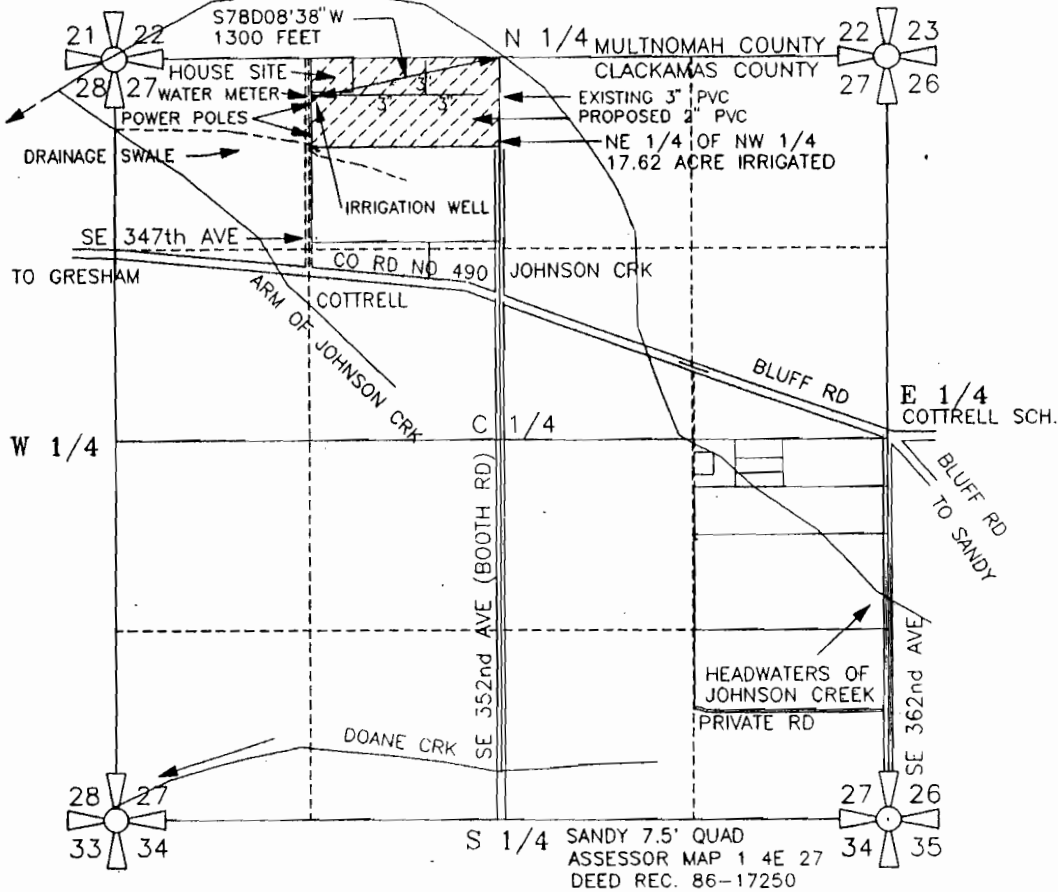


WELL IS LOCATED 268' SOUTH & 1275' WEST
OF THE NORTH CORNER OF SECTION 27, TOWNSHIP
1 SOUTH, RANGE 4 EAST OF WILLAMETTE MERIDIAN
IN THE COUNTY OF CLACKAMAS, STATE OF OREGON

PREPARATION OF THIS MAP WAS FOR THE PURPOSE
OF IDENTIFYING THE LOCATION OF THE WATER RIGHTS
ONLY AND HAS NO INTENT TO PROVIDE DIMENSIONS
OR LOCATION OF PROPERTY OWNERSHIP LINES.


FINAL PROOF SURVEY
GROUNDWATER PERMIT G-11910

PREPARED BY EDWARD A. CRANE, CWRE

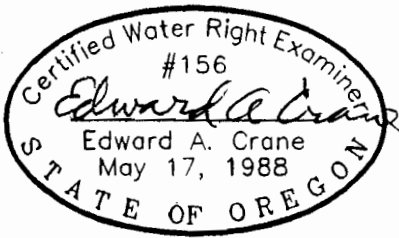

Renewal 12/31/97
Signed 5-14-96

SURVEYED FEB. 20, 1996
BY EDWARD A. CRANE, CWRE

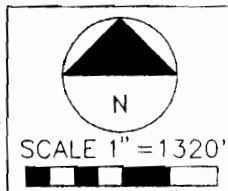

DATE
FEB. 1996
PROJECT NO.
170 001



CRANE & MERSETH
Engineering/Surveying
SUITE "D"
6566 SE LAKE ROAD
MILWAUKIE, OREGON 97222
BUS: (503) 654-2005
FAX: (503) 654-2575

APPLICATION FOR PERMIT NUMBER G-1329
PERMIT NUMBER G-11910 IN THE NAME OF:

HUGH & MARIDEAN EISELE
8620 SE 347th AVENUE
BORING, OREGON 97009 TEL: 503-663-6433

FIGURE
1/2

map amended by WRO staff 9-16-08 rwy