



# T.4S. R.3W. Sec. 21 and 22, W.M.

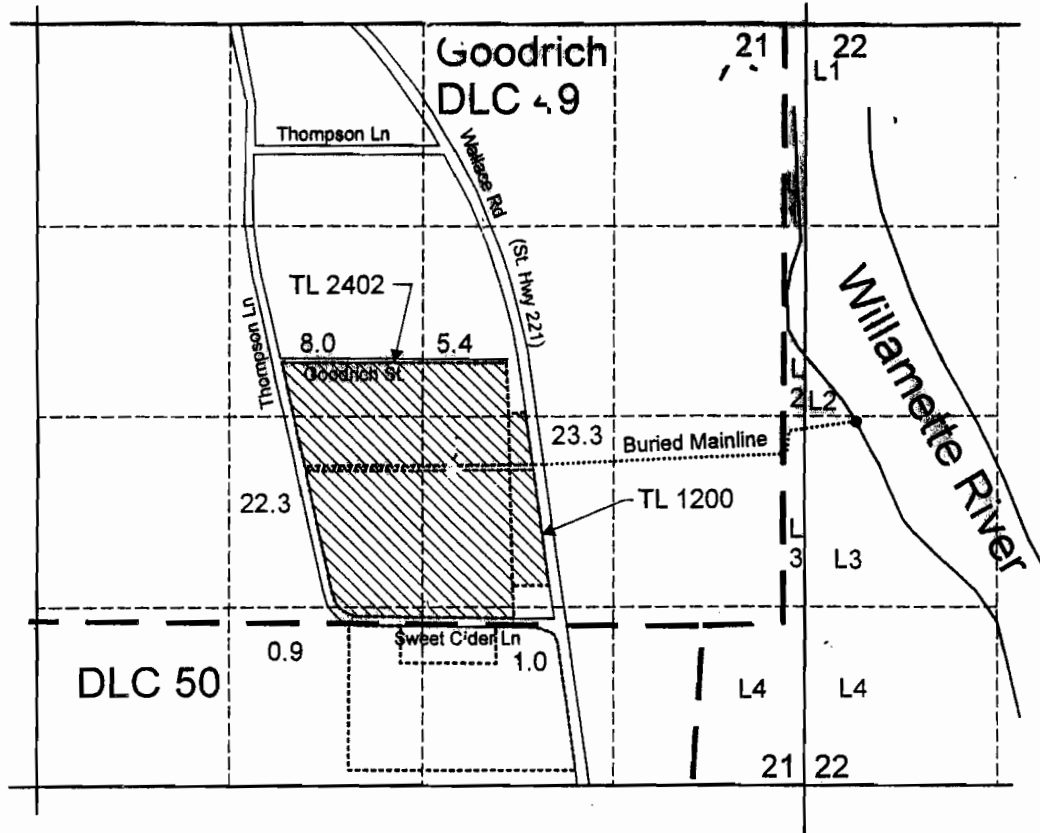

Diversion Point is located 1,440 feet north and 500 feet east from the SE corner of DLC 49.

 Area (60.9 Acres) irrigated under Application S-73278, Permit S-51672.


----- Tax lot boundary



EXPIRATION DATE: 6/30/09

Note: The quarter quarter lines have been projected using a tax map, government land survey maps, an aerial photograph, and best professional judgement.

Scale: 1" = 1,320'

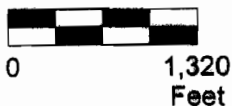

This map was prepared for the purpose of identifying the location of a water right only and is not intended to provide legal dimensions or location of property ownership lines.

Revised Claim of Beneficial Use Map  
Application S-73278, Permit S-51672

Carlton Plants  
Dayton Farm

Pacific Hydro-Geology Inc.

8/2008