


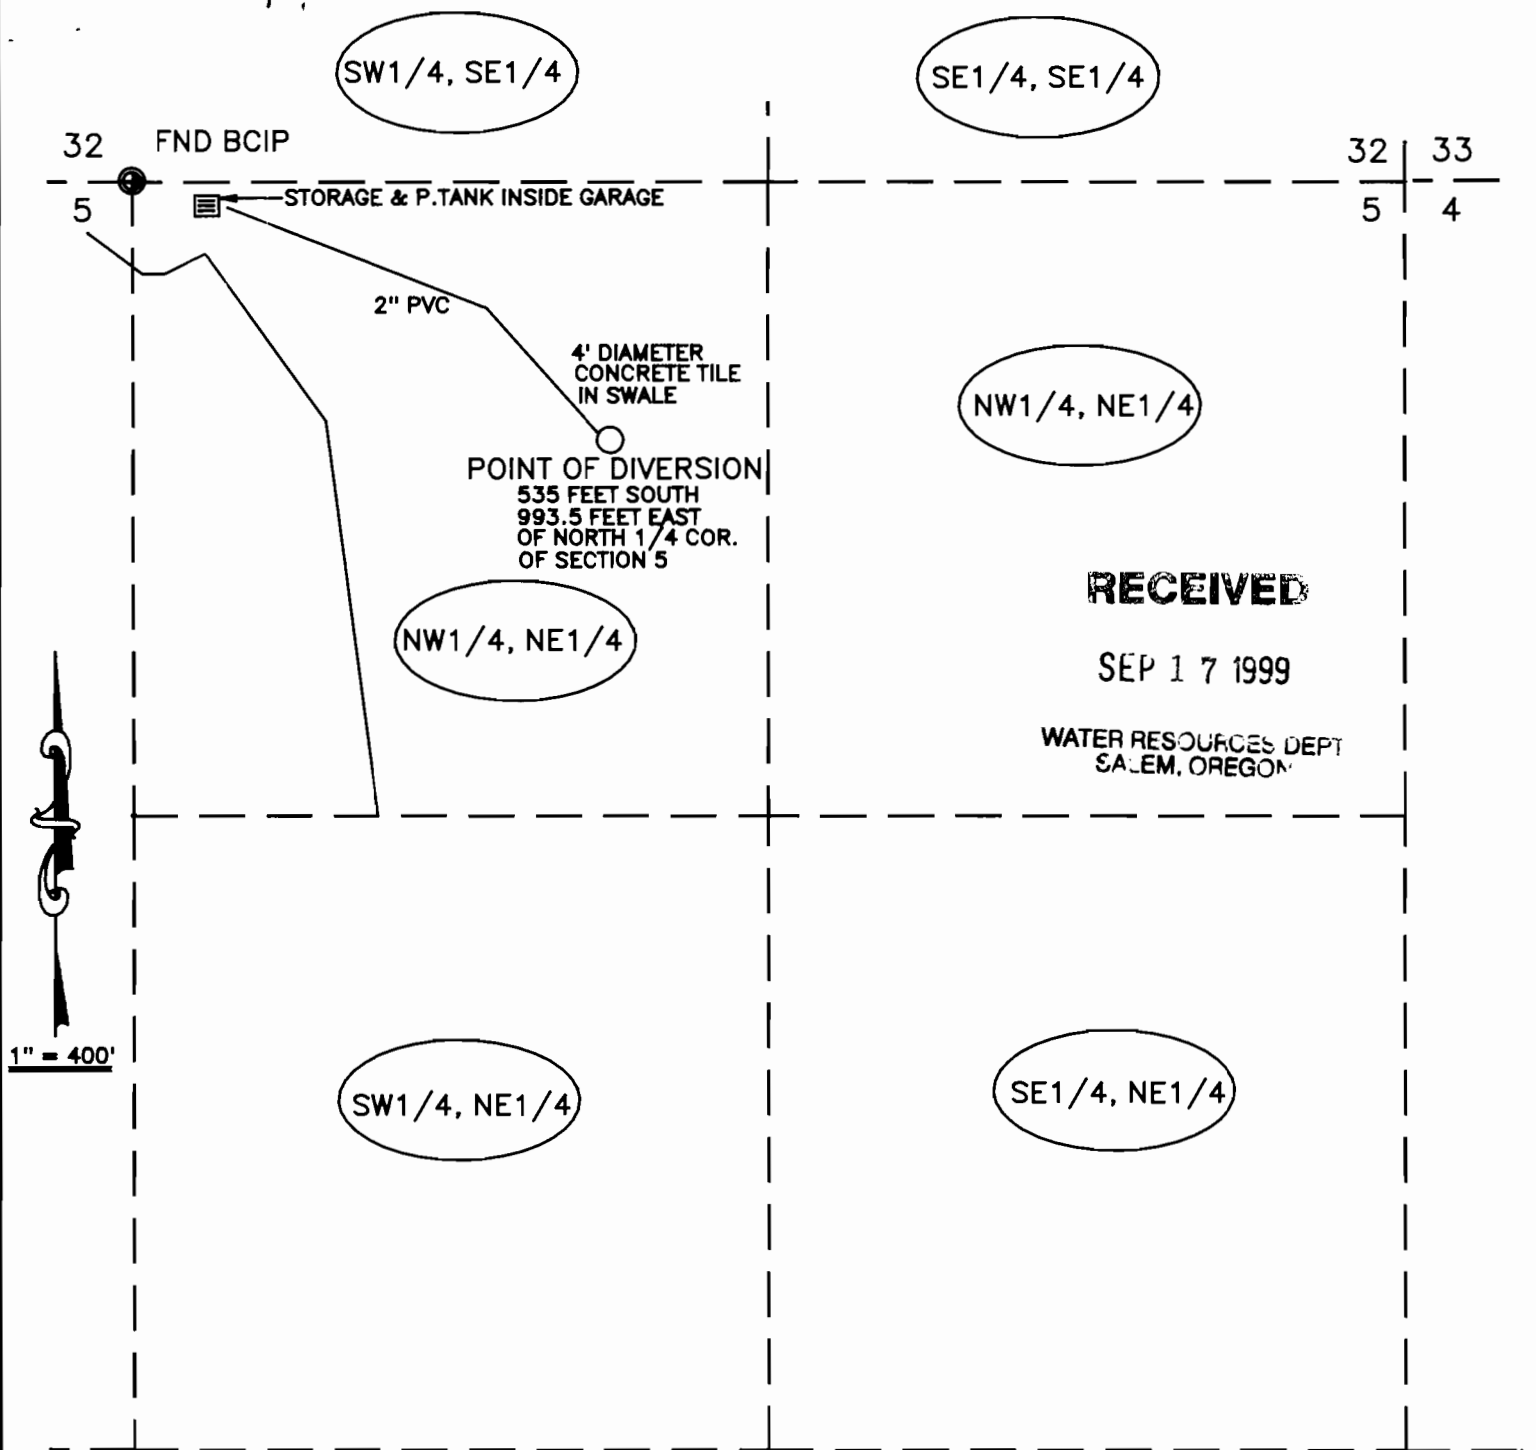

THE PREPARATION OF THIS MAP WAS FOR THE PURPOSE OF IDENTIFYING
THE LOCATION OF THE PROPOSED WATER RIGHT AND HAS NO INTENT TO
PROVIDE DIMENSIONS OR LOCATION OF PROPERTY LINES.

FINAL PROOF SURVEY

APPLICATION #72240

PERMIT #51585



IN THE NAME OF
PAUL & JANICE WEBER

NW 1/4, NE 1/4, SECTION 5
T. 35 S., R. 14 W., W. M.

SURVEYED SEPTEMBER 8, 1999 BY BRYAN M. FLAVIN