


# T.4S., R.12E., W.M.

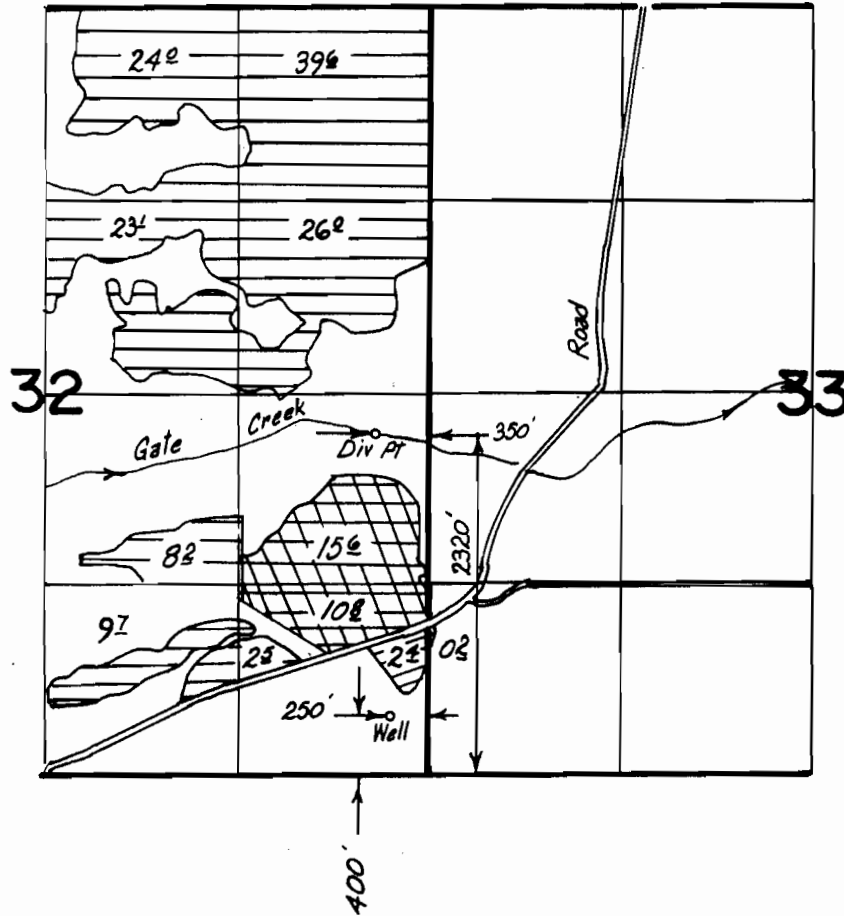




Scale: 1" = 1320'

## FINAL PROOF SURVEY UNDER

Application No. **G-9577** 58513 Permit No. **G-9254** 46164  
IN NAME OF

**RICHARD T. BLAINE**

Surveyed 6-21-1984, by Larry Tall

-  Gate Creek
-  Gate Creek, Well (Suppl)
-  Well (Primary)