



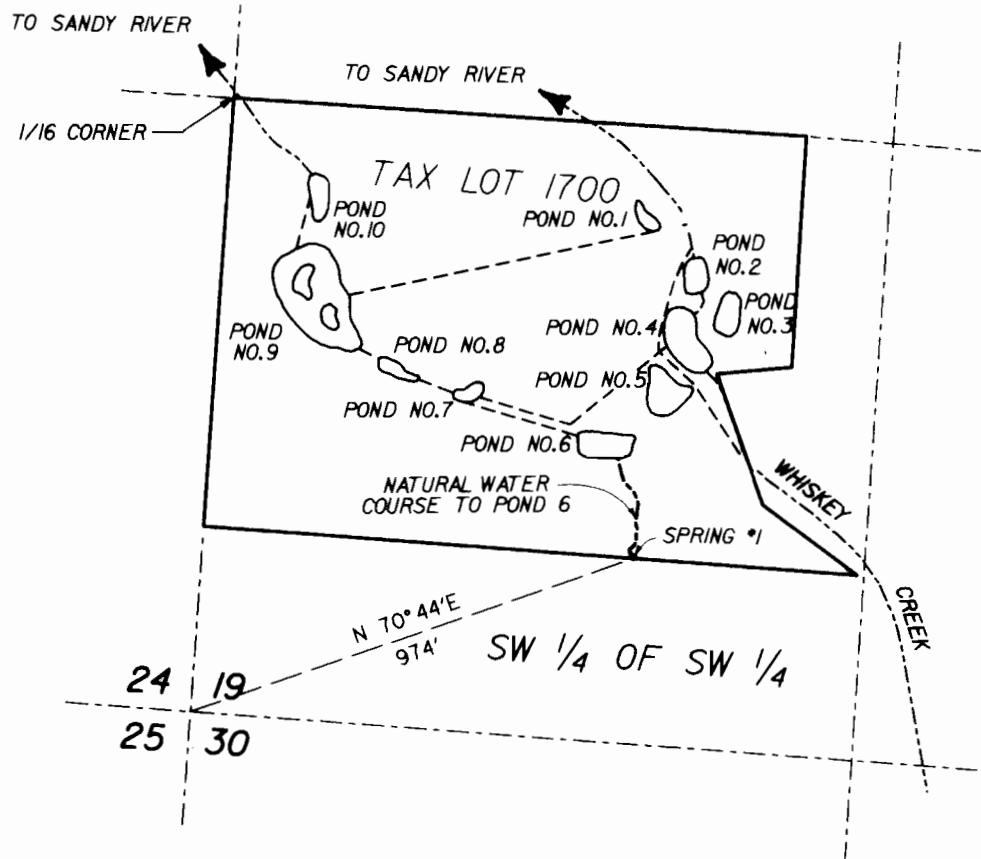

SCALE: 1" = 400'


SECTION 19, T.2S., R.6E., W.M.
CLACKAMAS COUNTY, OREGON

This drawing is an exhibit for a Water Right Transfer Proof Survey. It is not a Land Survey. Property lines and/or other lines of occupation show hereon are not represented by the undersigned to meet Land Survey accuracy standards.

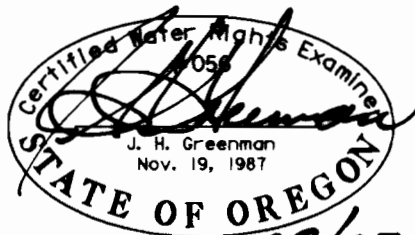

08/03/12

Transfer Application No. T-6780

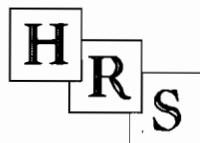

**HANER, ROSS &
SPORSEEN, INC.**

15 S.E. 82ND DRIVE
GLADSTONE, OREGON 97027

**MICHAEL D. KAISER
WATER RIGHT TRANSFER
PROOF SURVEY**

630K