

AREA OF DRIP
IRRIGATION
IN EXCESS OF 10 ACRES

AREA CLAIMED
FOR BENEFICIAL
USE UNDER
PERMIT-10 ACRES

----- 1" PLASTIC PIPE
----- 1.25 " PLASTIC PIPE
----- 2" PLASTIC PIPE

T 29 S, R 6 W WM

SECTION 35

SECTION SUBDIVISION
BASED SURVEY RM 3-12



IRRIGATION BOUNDARY
FROM SCALED AIR PHOTO
THIS MAP TO BE USED
FOR WATER RIGHT
PURPOSES ONLY

0 400 800

SCALE

SEE ALSO ATTACHED SITE REPORT

UNNAMED GULCH

SE 1/4 NE 1/4

0.6
ACRES
9.4
ACRES

1/4 CORNER
SEC 35/SEC 36
FND BC

S 07°02'51" E
1365.83

N 45°35' E 1138
PUMP
HOUSE
SPRING #2
STOCK
TROUGH

SPRING #3 BARN

FND BC
S 1/16 CORNER
SEC 35/SEC 36

NW 1/4 SE 1/4 NE 1/4 SE 1/4

SW 1/4 SE 1/4 SE 1/4 SE 1/4

SURVEY for CLAIM OF BENEFICIAL USE

APPLICATION S-73114
PERMIT 52888

UNNAMED GULCH
SPRING #4
STORAGE TANK
SPRING #5
STOCK TROUGH
S 61°32' W 821
S 58°12' W 767


IN NAME OF

Robert L. Muckey
Gayle A. Gennette

SEPTEMBER 23, 2000
WILLIAM J. RUPPERT
P.O. BOX 1564
MYRTLE CREEK, OR 97457

RECEIVED

SEP 28 2000

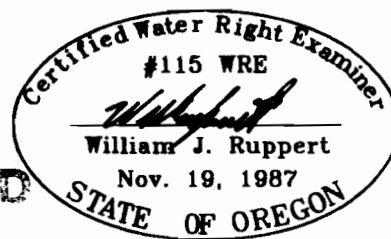

expires 12-31-00