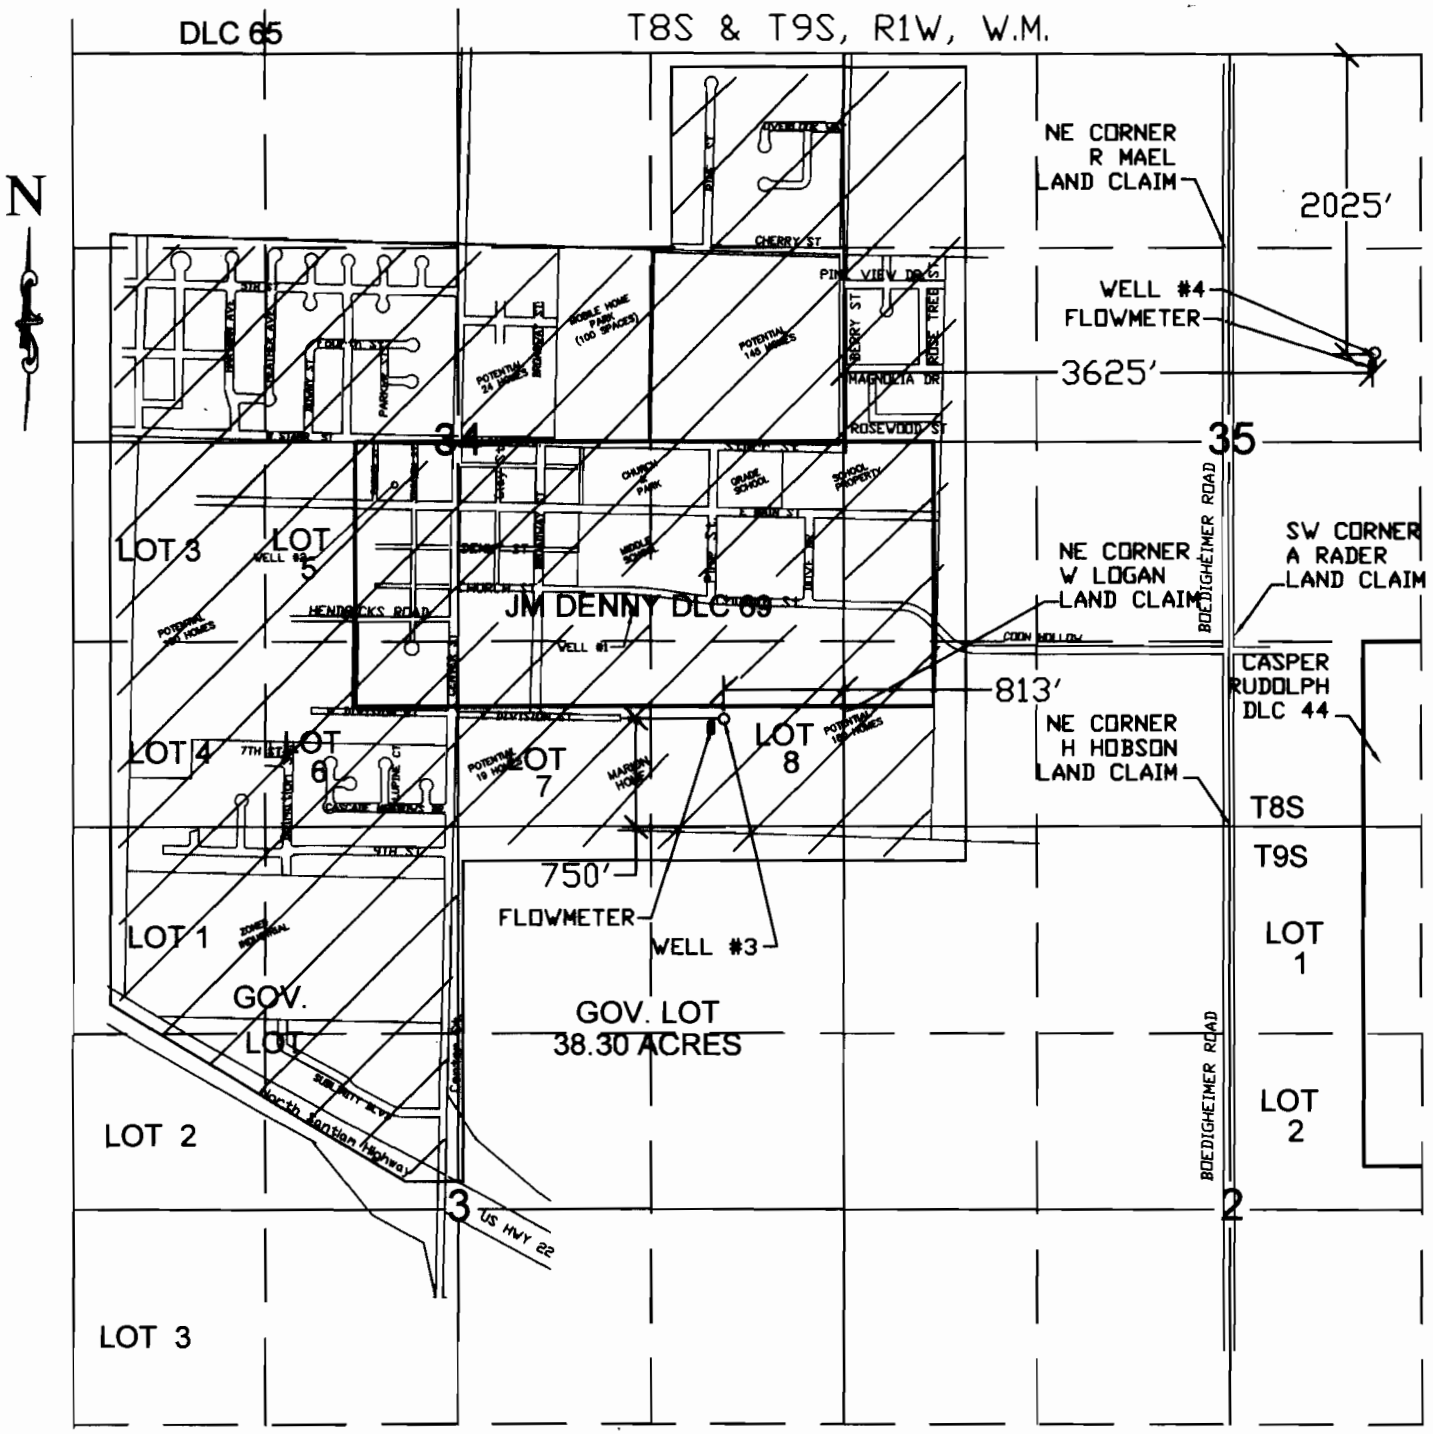

WELL #3 IS 750' NORTH AND 813' WEST OF THE SE CORNER T8S, R1W, SECTION 34.
WELL #4 IS 2025' SOUTH AND 3625' EAST OF THE NW CORNER OF T8S, R1W, SECTION 35.

RECEIVED
JUL 22 2008
WATER RESOURCES DEPT
SALEM, OREGON

FINAL PROOF SURVEY

UNDER

APPLICATION G-3085 PERMIT NO. G-2882 TRANSFER T-7064

SIGNIFIES AREA OF POINT OF USE

NOTE: MAP IS FOR SOLE PURPOSE OF IDENTIFYING LOCATION OF WATER RIGHT AND HAS NO INTENT TO DIMENSION OR LOCATE ANY PROPERTY OWNERSHIP LINES

Certified Water Right Examiner #027
Edward Butts
Nov 19, 1987
STATE OF OREGON

CITY OF SUBLIMITY
REVISED JULY 22, 2008

SCALE: 1" = 1320' 0"