


The purpose of this map is for identifying the location of the water right only and is not intended to provide legal dimensions of property ownership lines.

# FINAL PROOF SURVEY

UNDER  
**TRANSFER 6995**  
 IN NAME OF  
**DON R. STEPHENS**  
 Surveyed June 27, 1997

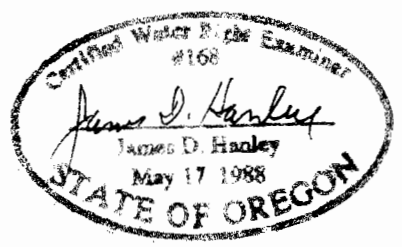

**RECEIVED**  
 SEP 28 1999  
 WATER RESOURCES DEPT  
 SALEM, OREGON