

T.7S., R.38E., W.M.

T.7S., R.39E., W.M.

T.8S., R.39E., W.M.

The purpose of this map is for identifying the location of the water right only and is not intended to provide legal dimensions of property ownership lines.

FINAL PROOF SURVEY


UNDER

TRANSFER 6995

IN NAME OF

DON R. STEPHENS

Surveyed June 27, 1997

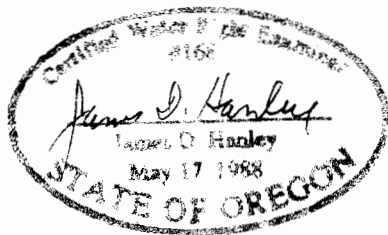

RECEIVED

SEP 28 1999

WATER RESOURCES DEPT.
SALEM, OREGON