


T. 24 S., R. 30 E., W. M.

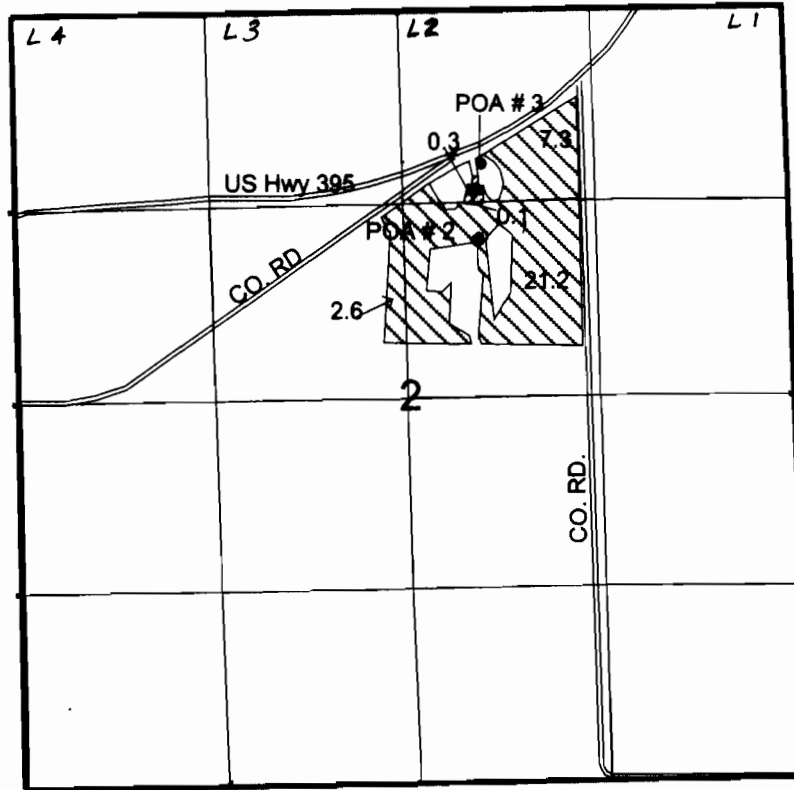

1" = 1320'

Well # 2 - 1554' South and 489' East from the North 1/4 Corner of Section 2.

Well # 3 - 1030' South and 560' East from the North 1/4 Corner of Section 2.

 Irrigated area from Well # 2.

 Irrigated area from Well # 3

 Irrigation under Certificate 31568

FINAL PROOF SURVEY

UNDER

Application No. G-11507 Permit No. G-10666

IN THE NAME OF

Sampson M. Duke

Surveyed 08-07-2001, by J. Miller