


T. 39 S., R. 11 E., W.M.

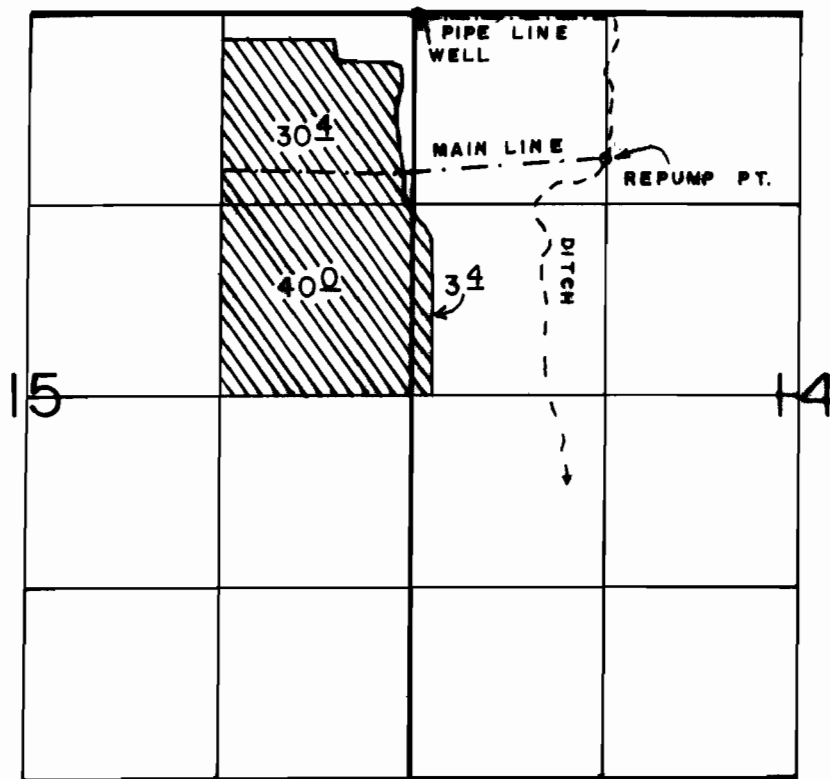

WELL LOC: 13'E FROM NW COR. OF SEC 14.

SCALE: 1"=1320'

FINAL PROOF SURVEY

UNDER

Application No. G-8680 Permit No. G-7998
IN NAME OF

MERLE R. & VIRGINIA P. WHITON

Surveyed JULY 6, 1992, by B.W. BISHOP