


AMENDED FINAL PROOF MAP Sections 20 & 21 T.39S. R.19E., W.M.

Lake County, Oregon

PERMIT #G-10817



SEPT 1 1995 = 299² acres
MAY 8, 1996 = 296⁴ acres

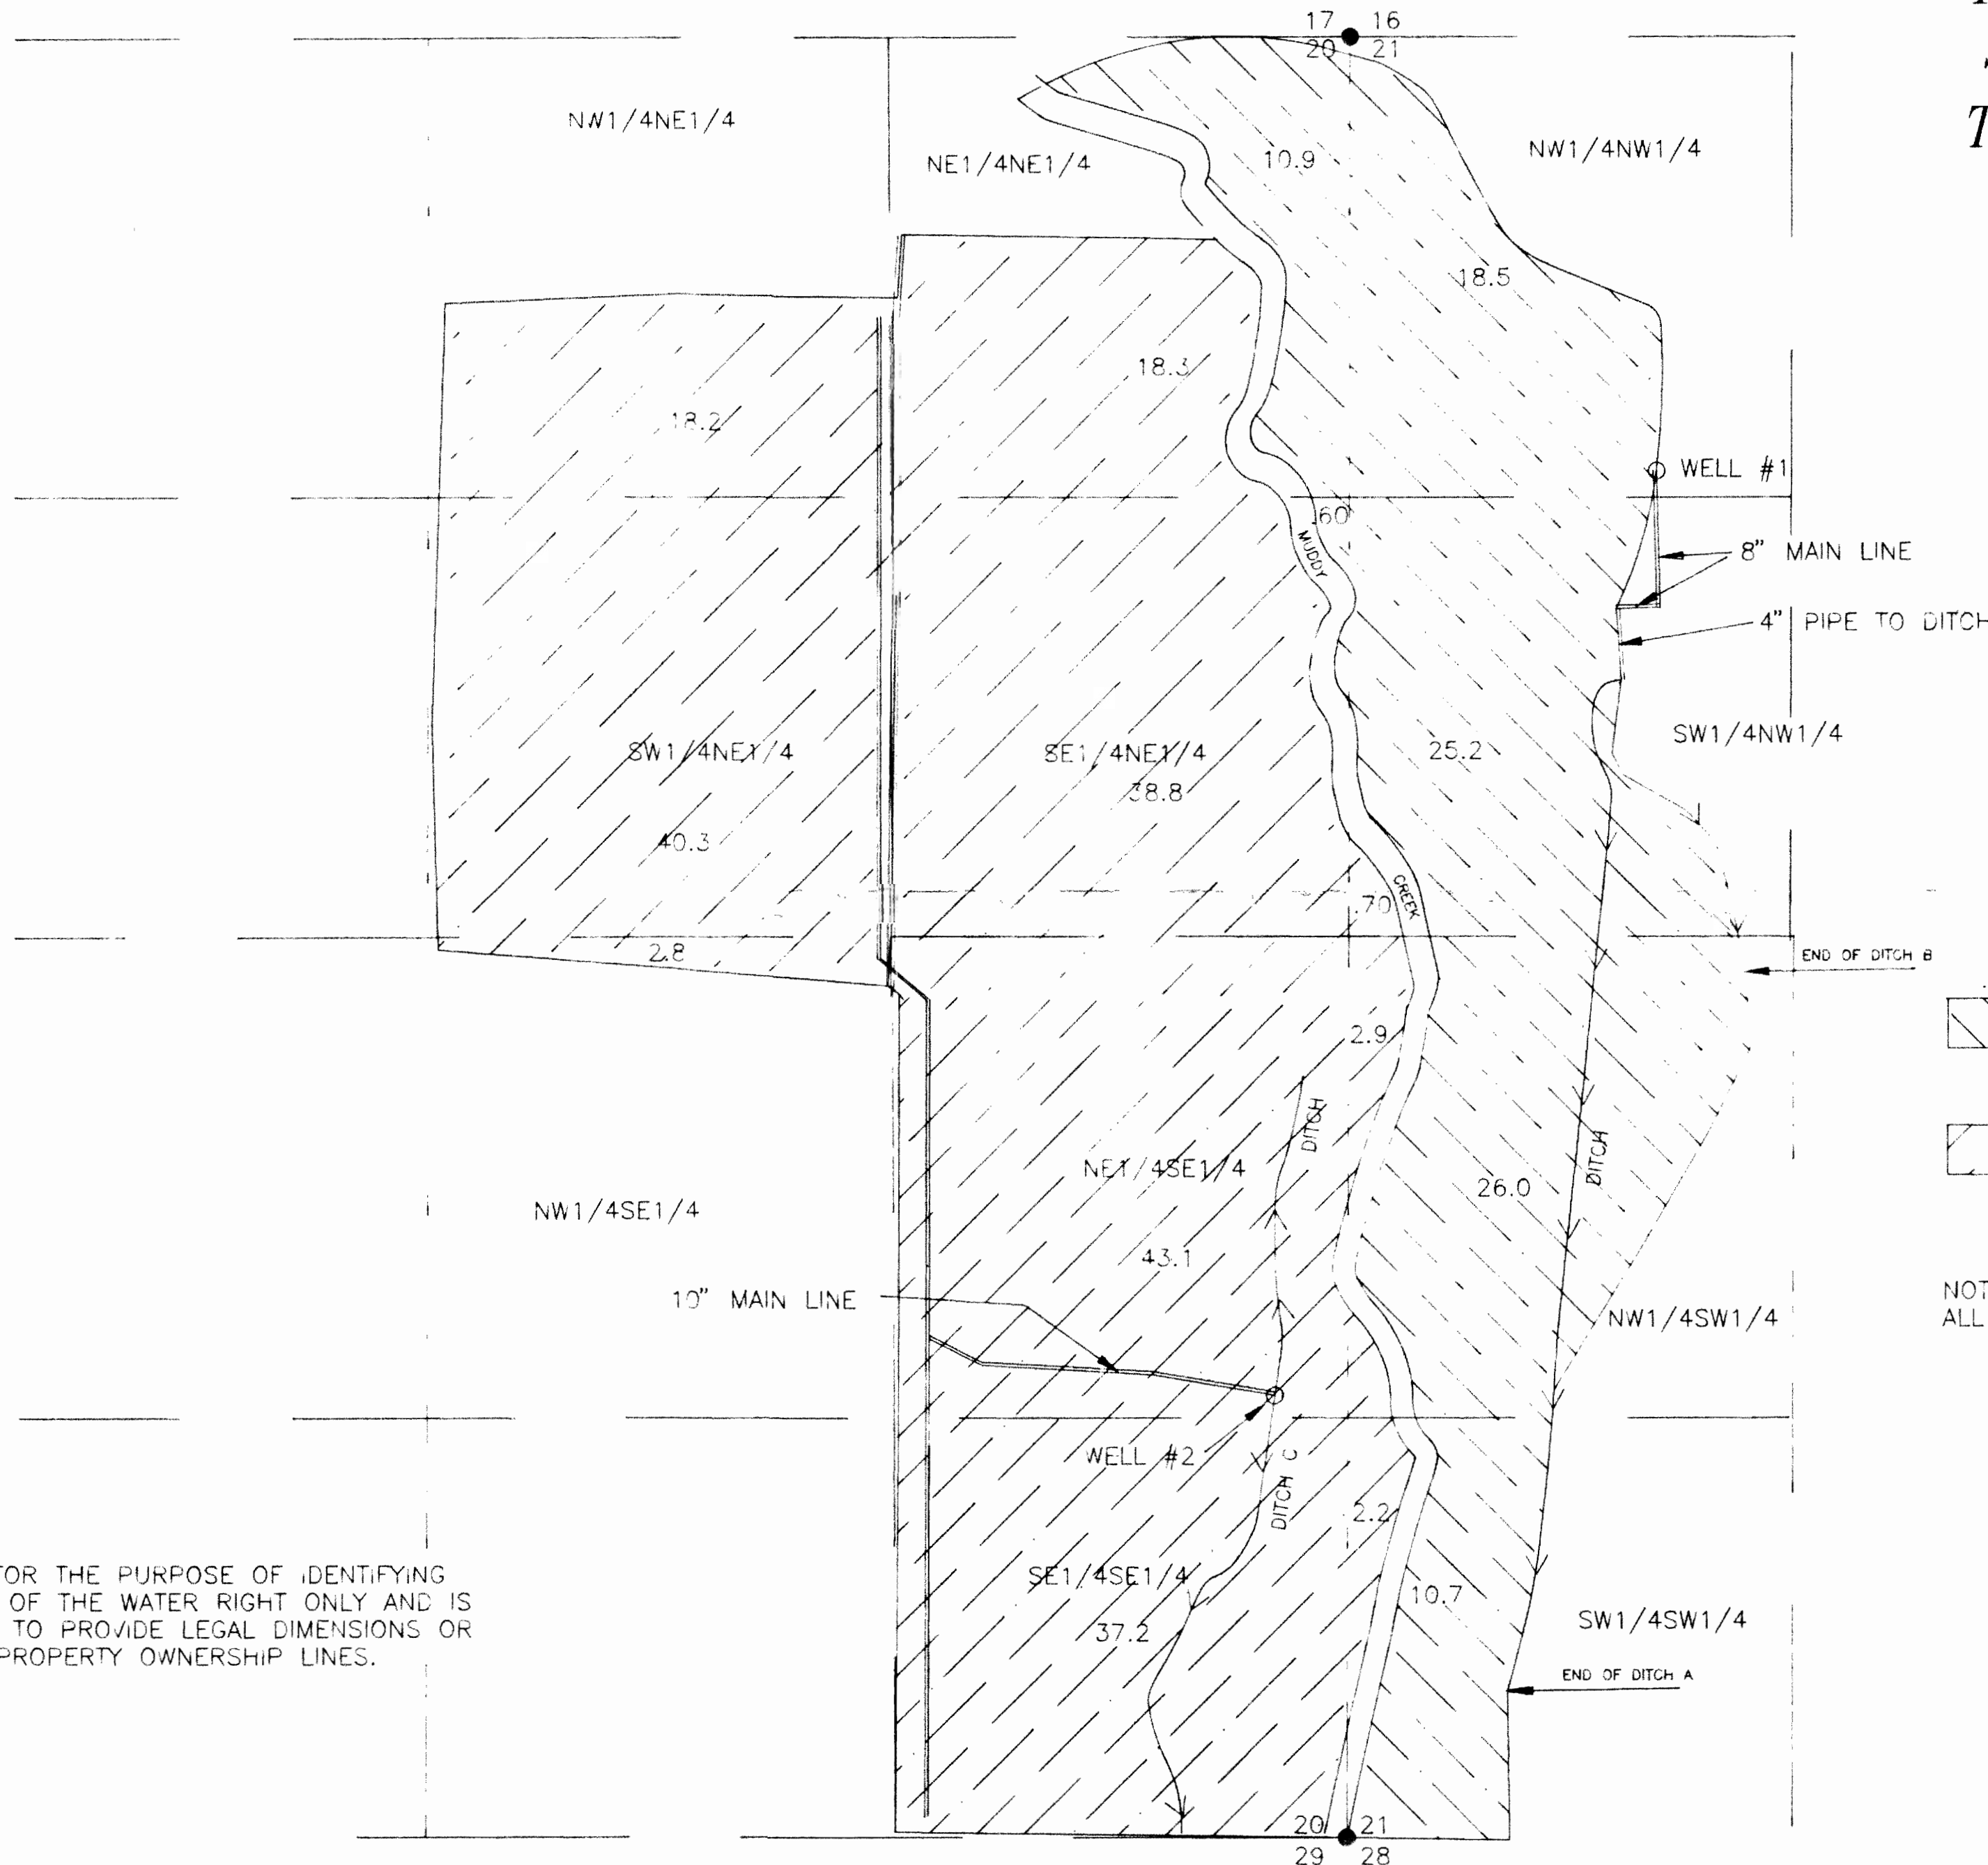

WELL #1
S35°14'54"E - 1576.94' FROM THE
NORTHEAST CORNER OF SECTION 20

WELL #2
N09°20'58"W - 1329.72' FROM THE
SOUTHEAST CORNER OF SECTION 20

NOTE
ALL DITCHES SHOWN ARE 2' WIDE X 1' DEEP



THIS MAP IS FOR THE PURPOSE OF IDENTIFYING
THE LOCATION OF THE WATER RIGHT ONLY AND IS
NOT INTENDED TO PROVIDE LEGAL DIMENSIONS OR
LOCATION OF PROPERTY OWNERSHIP LINES.

SURVEY FOR: DAN & FLORENCE PARKER
SURVEY BY: SUNDET & ASSOCIATES
424 NORTH 1ST STREET
P.O. BOX 1228
LAKEVIEW, OREGON 97630
(503) 947-3293

DATE: AUGUST 1995
Drawing #WR 7295