


T. 5 S., R. 2 W., W. M.

RECEIVED

SEP 26 1995

WATER RESOURCES DEPT
SALEM OREGON

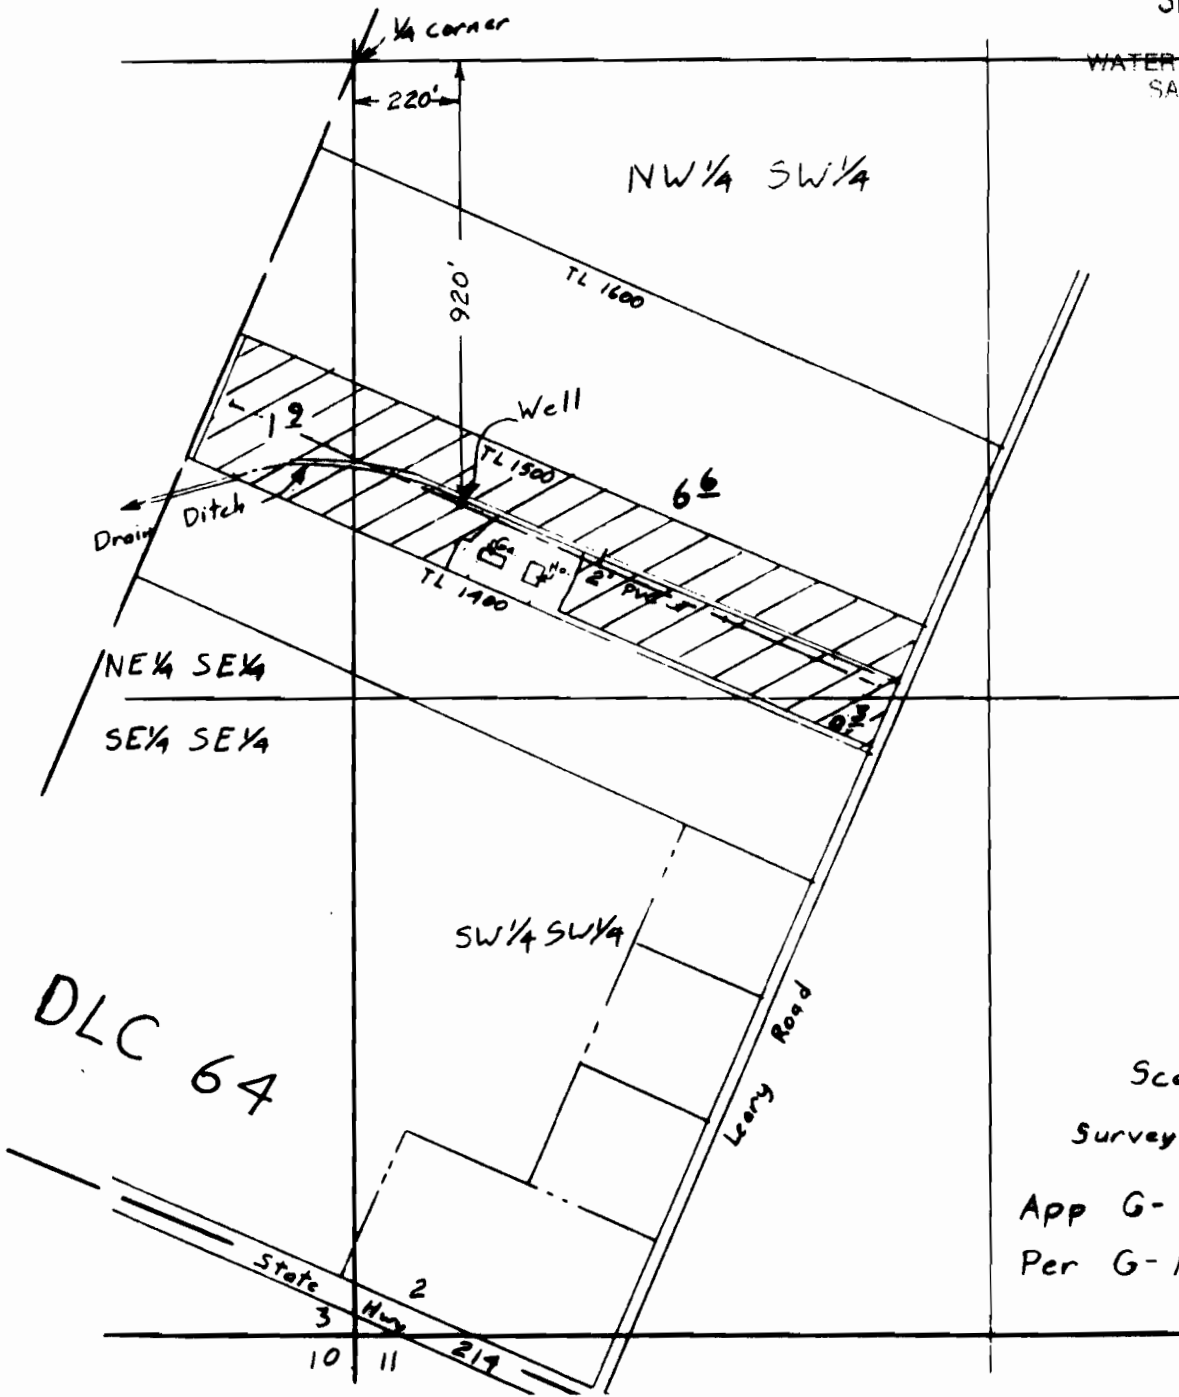

Scale 1" = 400'

Surveyed Sep 22, 1995

App G-12329

Per G-11202

Claim of Beneficial Use Map
for
DOUG CHADWICK'S
PLEASANT VALLEY FARM



ESTES SURVEYS

6293 Sunnyview Rd. NE
Salem, OR 97305
(503) 866-7888

60882 Arnold Rd.
Salem, OR 97302
(503) 866-7884

This map is for the purpose of locating a water right only and has no intent to provide legal dimensions or the location of property lines.