

T.1S., R.3E., W.M.
SECTION 23

West

CENTER
SECTION

1/4 CORNER

40'
PUBLIC
ROAD →

8.7 AC.
DERRICK

BURIED
5" MAIN

McNUTT ROAD

16.4 AC.


OBRIST

WELL
POINT

GA.
HO.

ACCESS ROAD

S.E.
HOGAN
ROAD

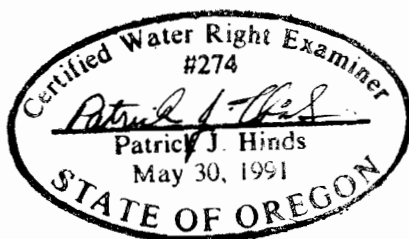

THE WELL POINT IS 1859 FEET NORTH
AND 225 FEET WEST OF THE SOUTH
1/4 CORNER OF SECTION 23.

22 23

27 26

SCALE 1" = 400'

BASIS OF BEARING P.S. # 51267, 50933,
16202

South
1/4 CORNER

FINAL PROOF SURVEY
UNDER

APPLICATION # G-12372 PERMIT # G-11351
IN THE NAME OF

DENNIS OBRIST

Surveyed July 7, 1995 By Patrick J. Hinds

RECEIVED

SEP - 2 1995
WATER RESOURCES DEPT.
SALEM, OREGON