

AMENDED CLAIM OF BENEFICIAL USE MAP
TRANSFER 7561
SECTIONS 22 & 27, T.34S. R.19E, W.M.
SOLHEIM RANCH
 Tax Lot 2000
 Lake County, Oregon

RECEIVED
 JUL 6 2000

WATER RESOURCES DEPT
 SALEM, OREGON

POA FOR 6.00 ACRES TRANSFERRED FROM
 PERMIT #G-9166 2630' SOUTH & 1310' WEST
 FROM THE NE CORNER SECTION 22 - WELL #2

POA FOR 21.80 ACRES TRANSFERRED FROM
 PERMIT #G-9166 10' SOUTH & 1310' EAST
 FROM THE NE CORNER SECTION 27 - WELL #4

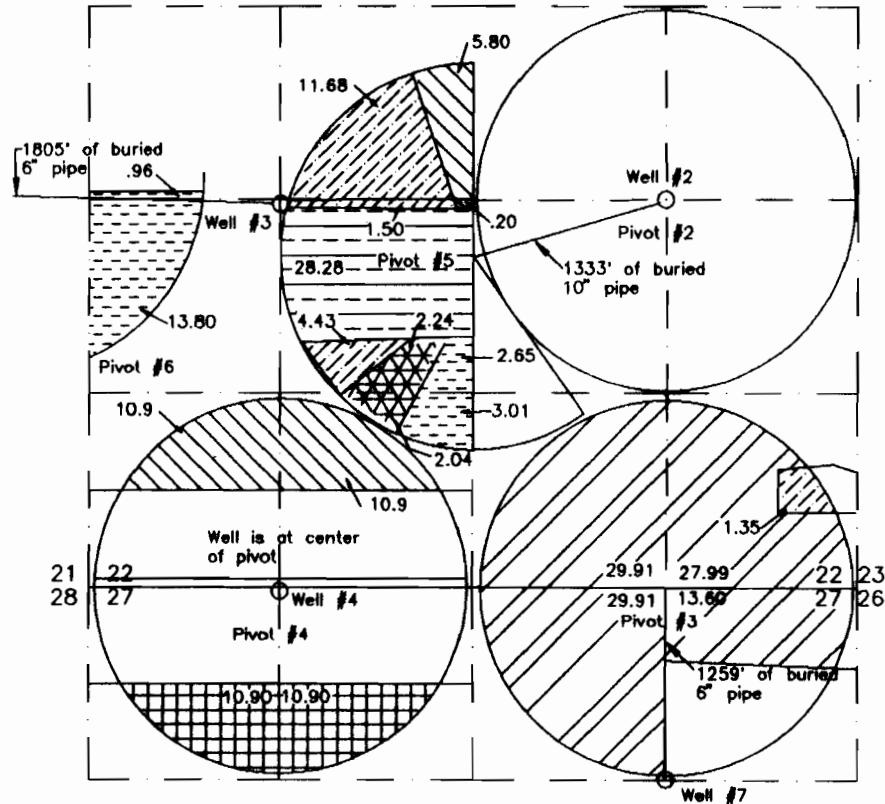
POA FOR 5.66 ACRES TRANSFERRED FROM
 PERMIT #G-4828 2630' SOUTH & 1310' WEST
 FROM THE NE CORNER SECTION 22 - WELL #2

POA FOR 17.61 ACRES TRANSFERRED FROM
 PERMIT #G-4827 2630' SOUTH & 1310' WEST
 FROM THE NE CORNER SECTION 22 - WELL #2

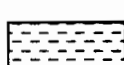
POA FOR 1.35 ACRES TRANSFERRED FROM
 PERMIT #G-4827 1300' SOUTH & 1310' WEST
 FROM THE NE CORNER SECTION 27 - WELL #7

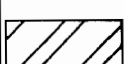
POA FOR 4.28 ACRES TRANSFERRED FROM
 PERMIT #G-6834 2630' SOUTH & 1310' WEST
 FROM THE NE CORNER SECTION 22 - WELL #2

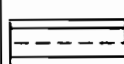
POA FOR 14.76 ACRES TRANSFERRED FROM
 PERMIT #G-4828 2720' SOUTH & 1320' EAST
 FROM THE NW CORNER SECTION 22 - WELL #3



T.34S. R.19E., W.M.
 SECTIONS 22 & 27

-  TRANSFERRED FROM
 PERMIT #G-6834 C#47921
-  TRANSFERRED FROM
 PERMIT #G-9166 C#54696
-  TRANSFERRED FROM
 PERMIT #G-4827 C#44626
-  TRANSFERRED FROM
 PERMIT #G-4828 C#44627

 POA FOR REMAINING ACREAGE IN
 PIVOT #3 - (103.33 Ac) 1300' SOUTH & 1310'
 WEST FROM THE NE CORNER SECTION 27 - PERMIT
 #G-4827 WELL #7

 POA FOR REMAINING ACREAGE IN
 PIVOT #5 - (28.28 Ac) 2630' SOUTH &
 1310' WEST FROM THE NW CORNER SECTION
 27 PERMIT #G-4828 WELL #2

 POA FOR REMAINING ACREAGE IN
 PIVOT #4 - (21.80 Ac) 10' SOUTH & 1320'
 EAST FROM THE NW CORNER SECTION 27
 PERMIT #G-9166 WELL #4

AUTHORIZED POA FOR PIVOT #2 & #3 - 2630' SOUTH
 & 1310' WEST FROM THE NE CORNER SECTION 22
 PERMIT #4827 WELL #2

AUTHORIZED POA FOR PERMIT #G-4828
 IS 2720' SOUTH & 1320' EAST FROM THE
 NW CORNER SECTION 22 - WELL #3



SCALE
 1" = 1320



Revised 6/30/10

Surveyed by: Sundet & Associates

P.O. Box 1228
 Lakeview, OR 97630
 541-947-3293

June 2001 Dr. # 13701am

This map is for the purpose of identifying the
 location of the water right only and is not
 intended to provide legal dimensions or location
 of property ownership lines.

7-08 JS

Amended 8/2007