

AMENDED CLAIM OF BENEFICIAL USE MAP
TRANSFER 7561
SECTIONS 22 & 27, T.34S. R.19E, W.M.
SOLHEIM RANCH
Tax Lot 2000
Lake County, Oregon

RECEIVED

JUL 16 2008

WATER RESOURCES
SALMON REGION

POA FOR 6.00 ACRES TRANSFERRED FROM
PERMIT #G-9166 2630' SOUTH & 1310' WEST
FROM THE NE CORNER SECTION 22 - WELL #2

POA FOR 21.80 ACRES TRANSFERRED FROM
PERMIT #G-9166 10' SOUTH & 1320' EAST
FROM THE NE CORNER SECTION 27 - WELL #4


POA FOR 5.66 ACRES TRANSFERRED FROM
PERMIT #G-4828 2630' SOUTH & 1310' WEST
FROM THE NE CORNER SECTION 22 - WELL #2

POA FOR 17.61 ACRES TRANSFERRED FROM
PERMIT #G-4827 2630' SOUTH & 1310' WEST
FROM THE NE CORNER SECTION 22 - WELL #2

POA FOR 1.35 ACRES TRANSFERRED FROM
PERMIT #G-4827 1300' SOUTH & 1310' WEST
FROM THE NE CORNER SECTION 27 - WELL #7

POA FOR 4.28 ACRES TRANSFERRED FROM
PERMIT #G-6834 2630' SOUTH & 1310' WEST
FROM THE NE CORNER SECTION 22 - WELL #2

POA FOR 14.76 ACRES TRANSFERRED FROM
PERMIT #G-4828 2720' SOUTH & 1320' EAST
FROM THE NW CORNER SECTION 22 - WELL #3

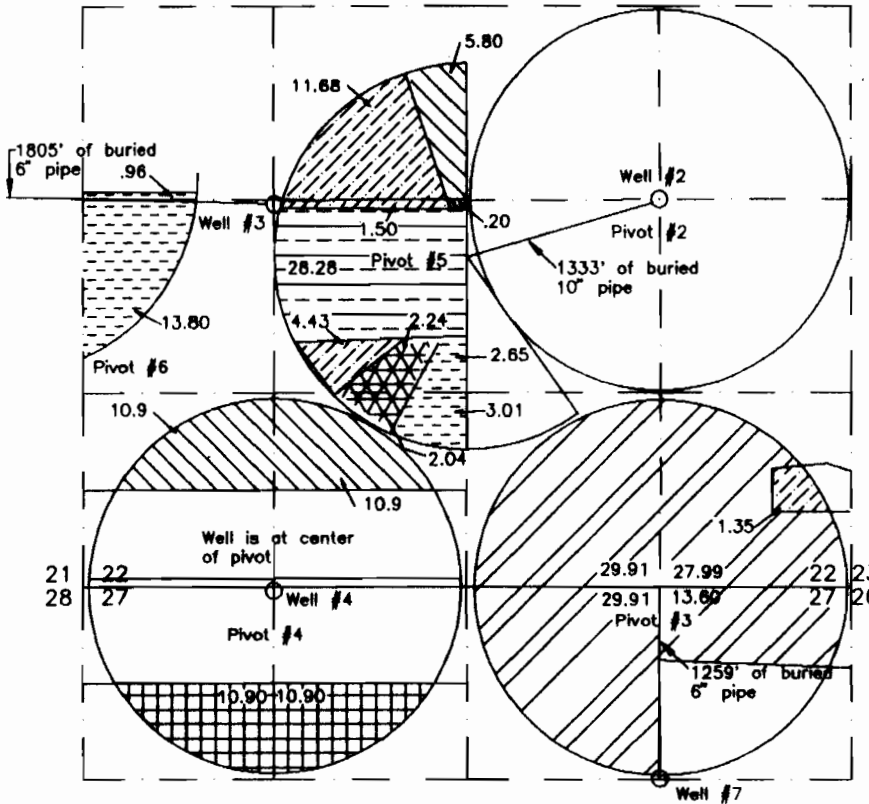

T.34S. R.19E., W.M.
SECTIONS 22 & 27




TRANSFERRED FROM
PERMIT #G-6834 C#47921



TRANSFERRED FROM
PERMIT #G-9166 C#54696




TRANSFERRED FROM
PERMIT #G-4827 C#44626

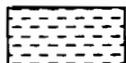

TRANSFERRED FROM
PERMIT #G-4828 C#44627



POA FOR REMAINING ACREAGE IN
PIVOT #3 - (103.33 Ac) 1300' SOUTH & 1310'
WEST FROM THE NE CORNER SECTION 27 - PERMIT
#G-4827 WELL #7

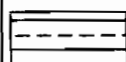

POA FOR REMAINING ACREAGE IN
PIVOT #5 - (28.28 Ac) 2630' SOUTH &
1310' WEST FROM THE NW CORNER SECTION
27 PERMIT #G-4828 WELL #2



POA FOR REMAINING ACREAGE IN
PIVOT #4 - (21.80 Ac) 10' SOUTH & 1320'
EAST FROM THE NW CORNER SECTION 27
PERMIT #G-9166 WELL #4



SCALE

1" = 1320

AUTHORIZED POA FOR PIVOT #2 & #3 - 2630' SOUTH
& 1310' WEST FROM THE NE CORNER SECTION 22
PERMIT #4827 WELL #2

AUTHORIZED POA FOR PERMIT #G-4828
IS 2720' SOUTH & 1320' EAST FROM THE
NW CORNER SECTION 22 - WELL #3



Revised 6/30/10

Surveyed by: Sundet & Associates

P.O. Box 1228
Lakeview, OR 97630
541-947-3293
Dr. # 13701am

June 2001

This map is for the purpose of identifying the
location of the water right only and is not
intended to provide legal dimensions or location
of property ownership lines.

7-08 35

Amended 8/2007