



THIS MAP WAS PREPARED FOR THE PURPOSE OF IDENTIFYING THE LOCATION OF THE WATER RIGHT AND IS NOT INTENDED TO PROVIDE LEGAL DIMENSIONS OR LOCATIONS OF PROPERTY OWNERSHIP LINES.

RECEIVED

MAY 29 1996

T6S; R38E

WATER RESOURCES DEPT.
SALEM, OREGON

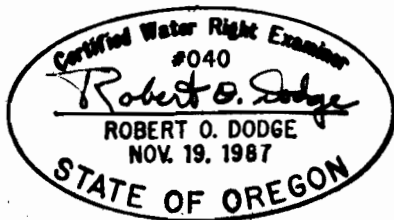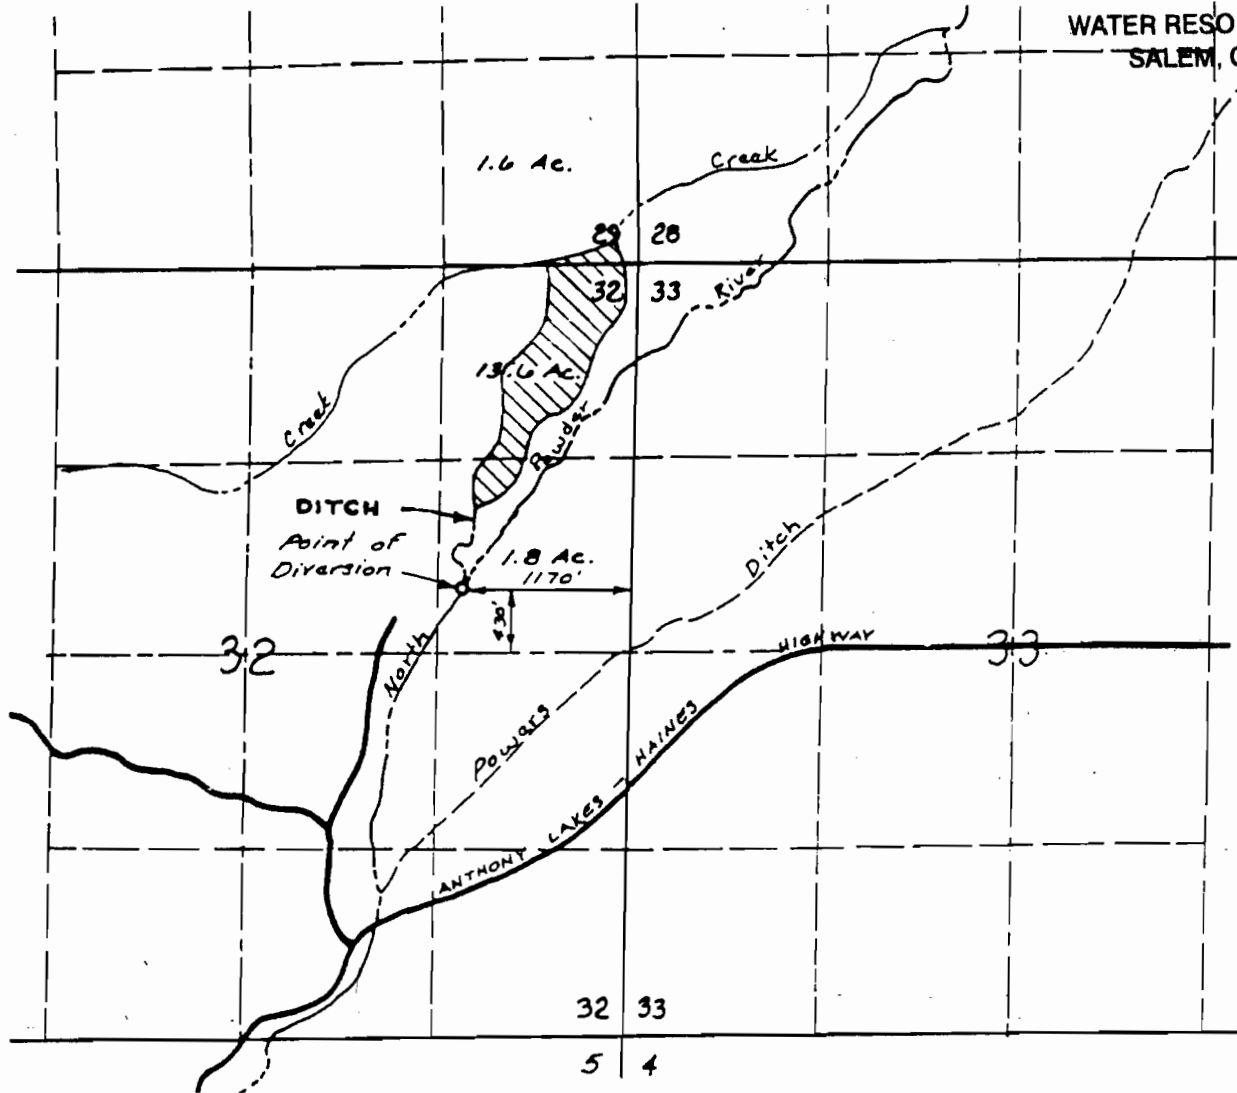

SCALE: 1" = 1320'

**FINAL PROOF SURVEY
UNDER**

APPLICATION NO. S-71513 PERMIT NO. 51779
IN NAME OF

OREGON DEPARTMENT OF FISH AND WILDLIFE

SURVEYED: 5/23/96 BY: DODGE