
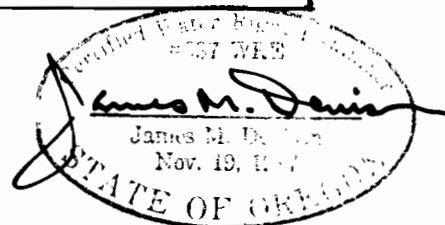


RECEIVED

SEP 30 1999

WATER RESOURCES DEPT.
SALMON, OREGON

T10S. R10W.
NE1/4 - NE1/4 SECTION 36
T10S. R9W.
NW1/4 - NW 1/4 SECTION 31 W. M.
LINCOLN COUNTY, OREGON
Scale: 1 inch = 440 feet

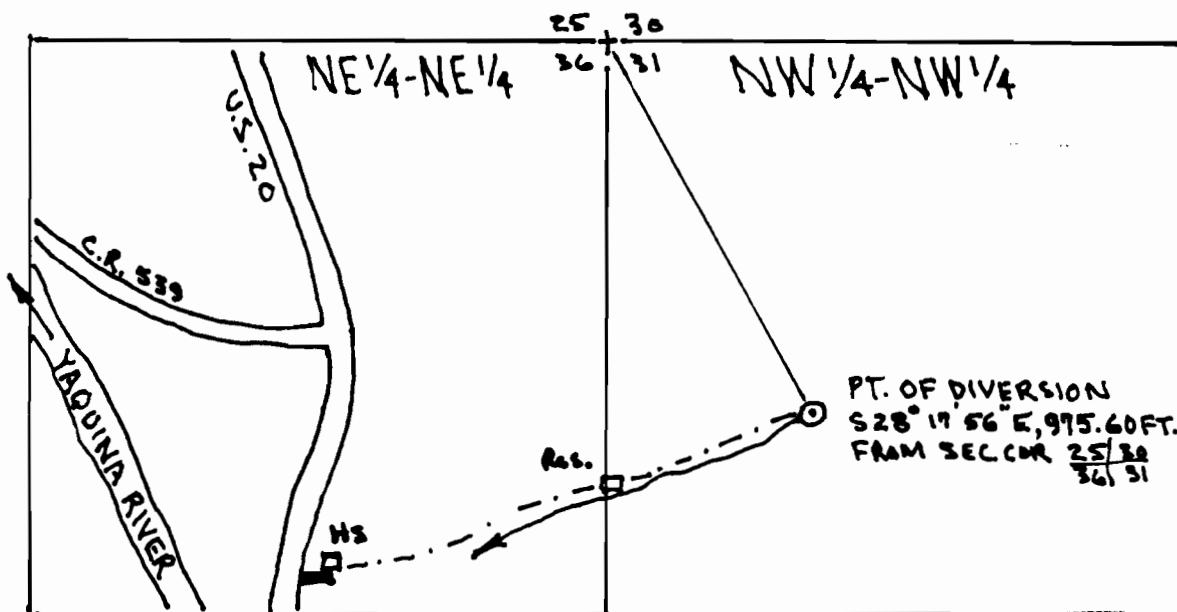

FINAL PROOF SURVEY
UNDER

APPLICATION # S-72741

PERMIT # 52173

IN THE NAME OF

Raymond F. & Betty Jean Wolf

SURVEYED: September 23, 1999

BY: J. M. DENISON

THIS MAP PREPARED SOLEY FOR THE PURPOSE OF SHOWING LOCATION OF A WATER RIGHT, AND IS NOT INTENDED FOR USE FOR PROVIDE DIMENSIONS OR LOCATION OF PROPERTY OWNERSHIP LINES.