


T.33S.,R.2E.,W.M.

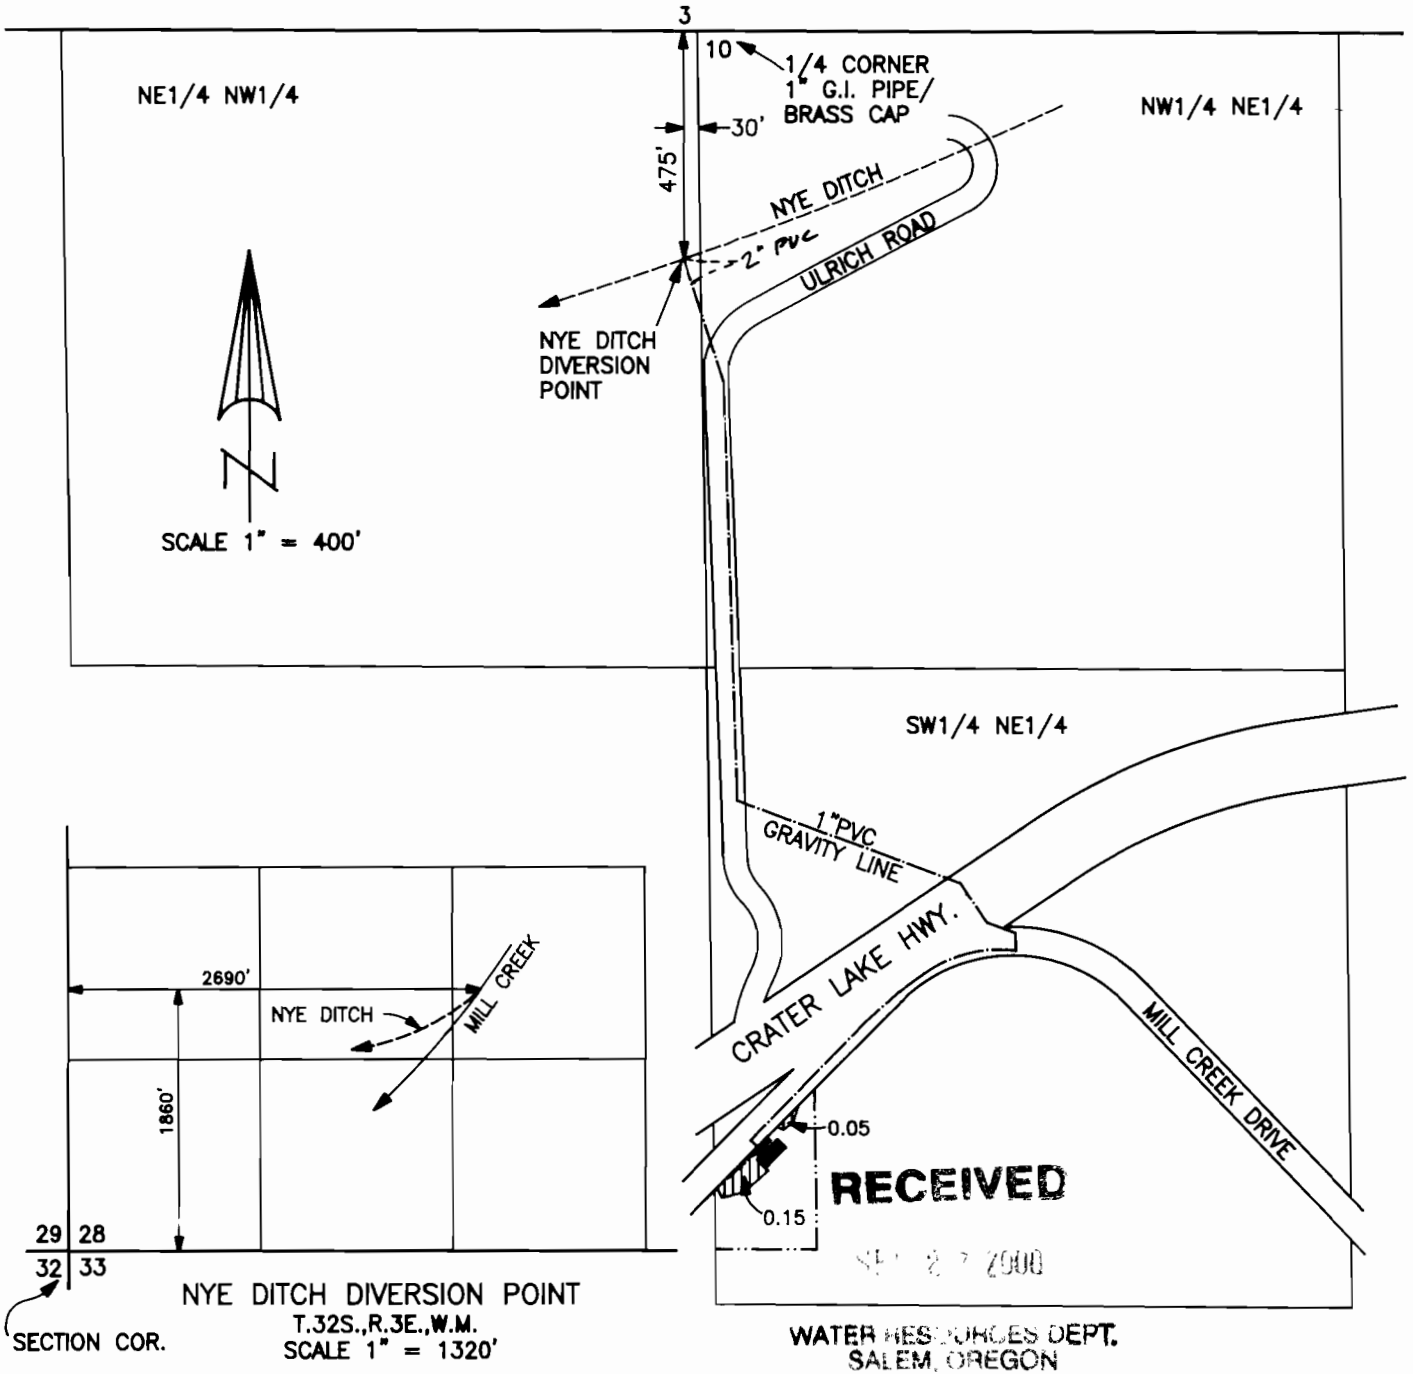

FINAL PROOF MAP

APPLICATION No. S-70377
 PERMIT No. 52425

IN THE NAME OF
LONNY W. & EDNA J. GALLAGHER

NOTE: MAP PREPARED FOR
 WATER RIGHT PURPOSES ONLY,
 NOT FOR PROPERTY BOUNDARY
 LOCATIONS.

MAP PREPARED SEPTEMBER 11, 2000
 BY GARY D. KAISER

