

**RECEIVED**

Coos County

E1/4

C1/4

JAN 10 1997

CE1/16

WATER RESOURCES DEPT.  
SALEM, OREGON

NE1/4 SE1/4

Devore Arm  
S46°40'E 1120'  
South Tenmile Lake

N8°22'W  
1840'



Legend


- P.O.D.
- - - - - Property Line
- - - - - Waterline
- House

S19 S20  
S30 S29

S1/4

EXAMINERS DISCLAIMER STATEMENT

The preparation of this map was for the purpose of identifying the location of the Water Right only and has no intent to provide dimensions or location of property ownership lines.

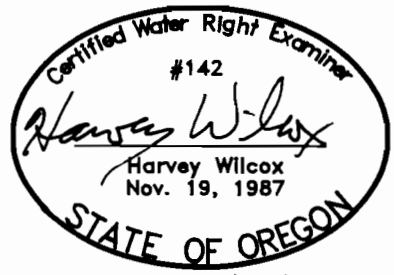

RENEWAL 6/30/98

**FINAL PROOF SURVEY**

IN THE NAME OF

David Edward Smith

Surveyed on 11/8/96 by H.A. Wilcox

Application No. S-73763  
Permit No. 52506