


TOWNSHIP 28 SOUTH, RANGE 14 WEST W.M.  
**RECEIVED**

JUL 27 1999

WATER RESOURCES DEPT  
SALEM, OREGON

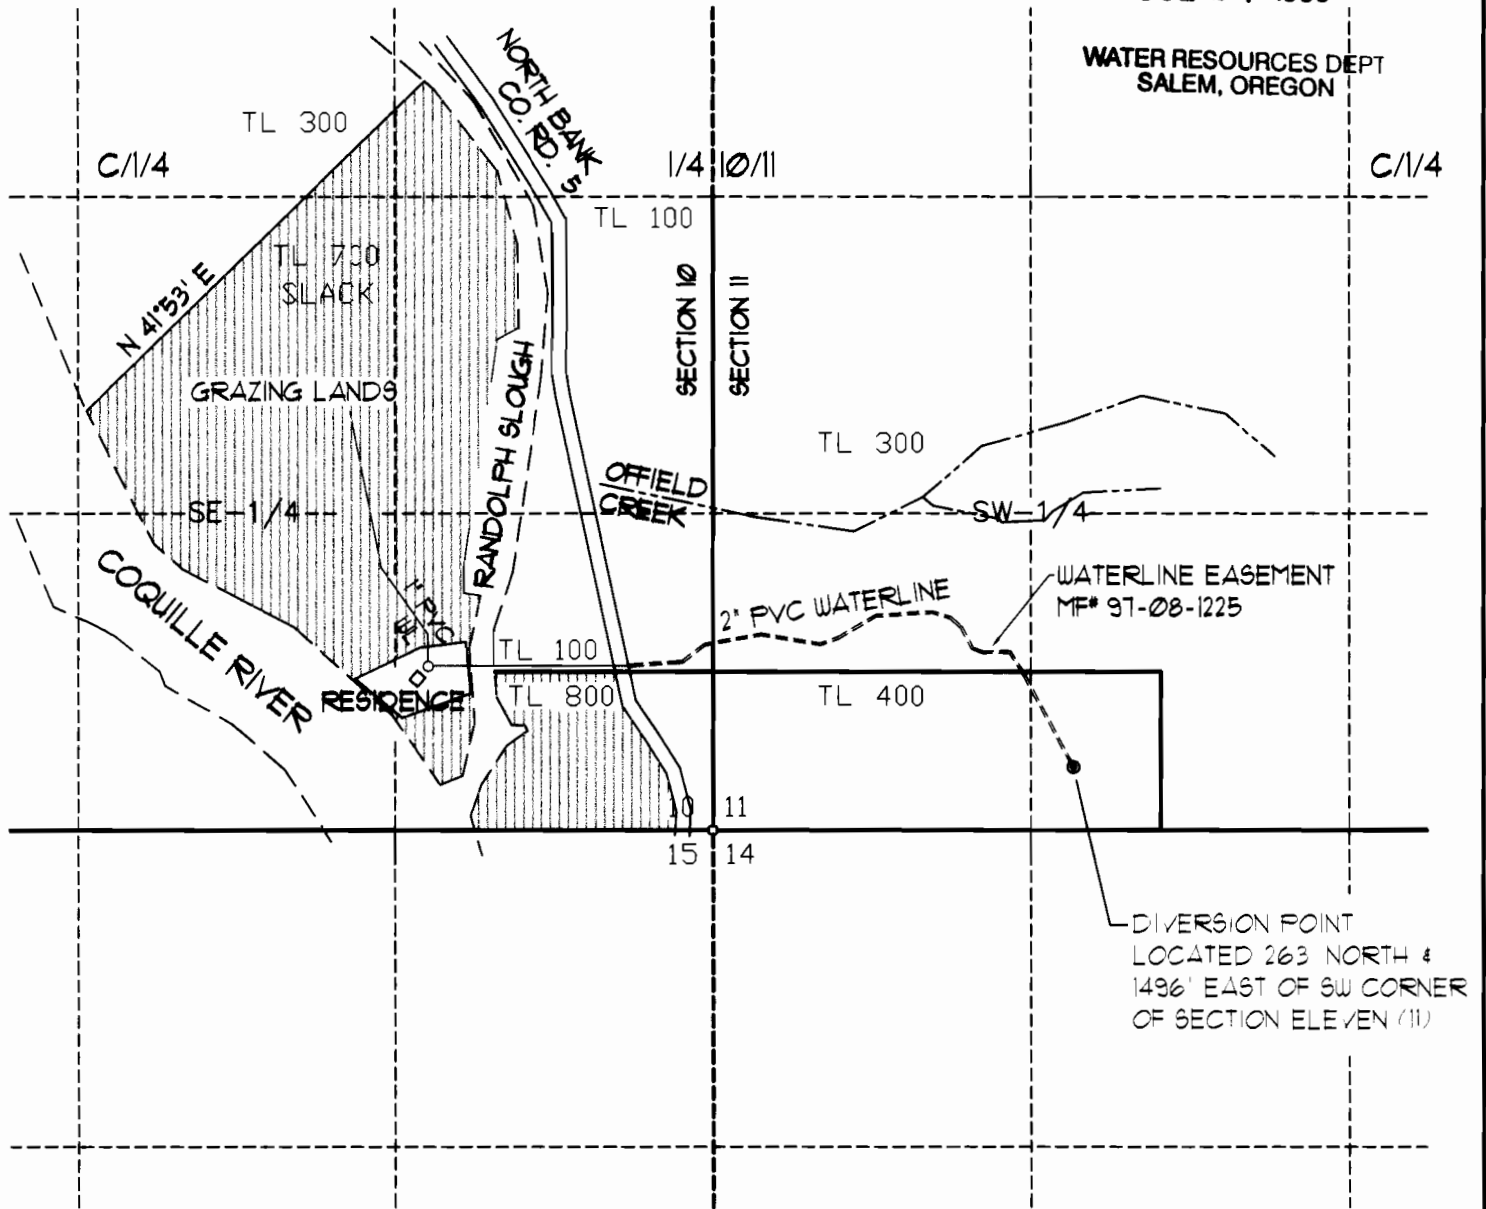


FINAL PROOF SURVEY

SCALE: 1" = 800'

UNDER

APP. NO. S - 75371, PER NO. 52975

JULY 13, 1999

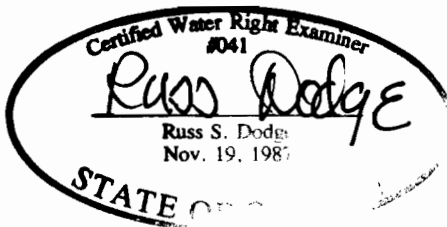

THIS MAP WAS PREPARED FOR THE PURPOSE OF IDENTIFYING THE LOCATION OF A WATER RIGHT ONLY AND IS NOT INTENDED TO PROVIDE LEGAL DIMENSIONS OR LOCATION OF PROPERTY OWNERSHIP LINES.