


T. 3 S., R. 1 E., W.M.

SECTION 13

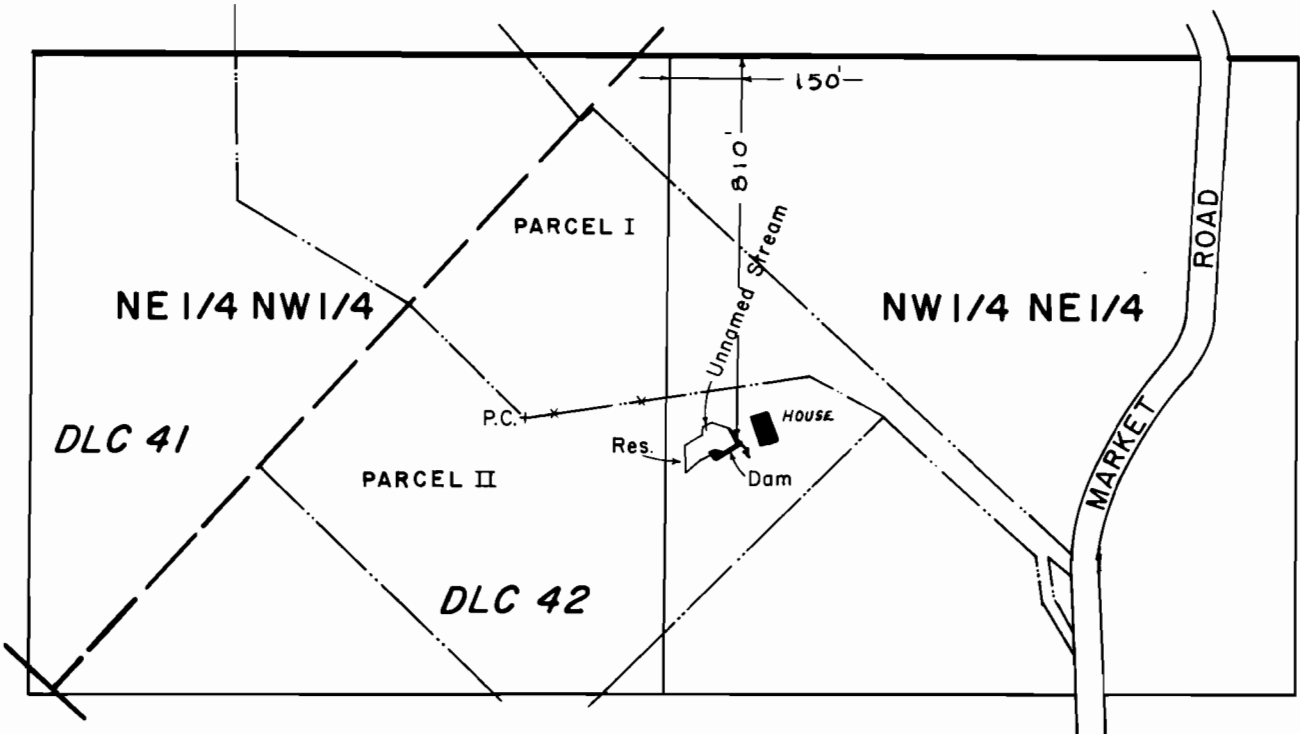

SCALE: 1" = 400'

FINAL PROOF SURVEY
UNDER

R-69021 R-10825

Application No. 69022. Permit No. 49976....

IN NAME OF

ROBERT JAMES LOFGREN.....

Surveyed ^{APRIL 1 91} MAY 15, 1990, by ^{R. W. KLASSEN} T. M. WARREN

6-15-90

PTS

REVISED 2/93 RWK