


T. 3 S., R. 1 E., W.M.

SECTION 13

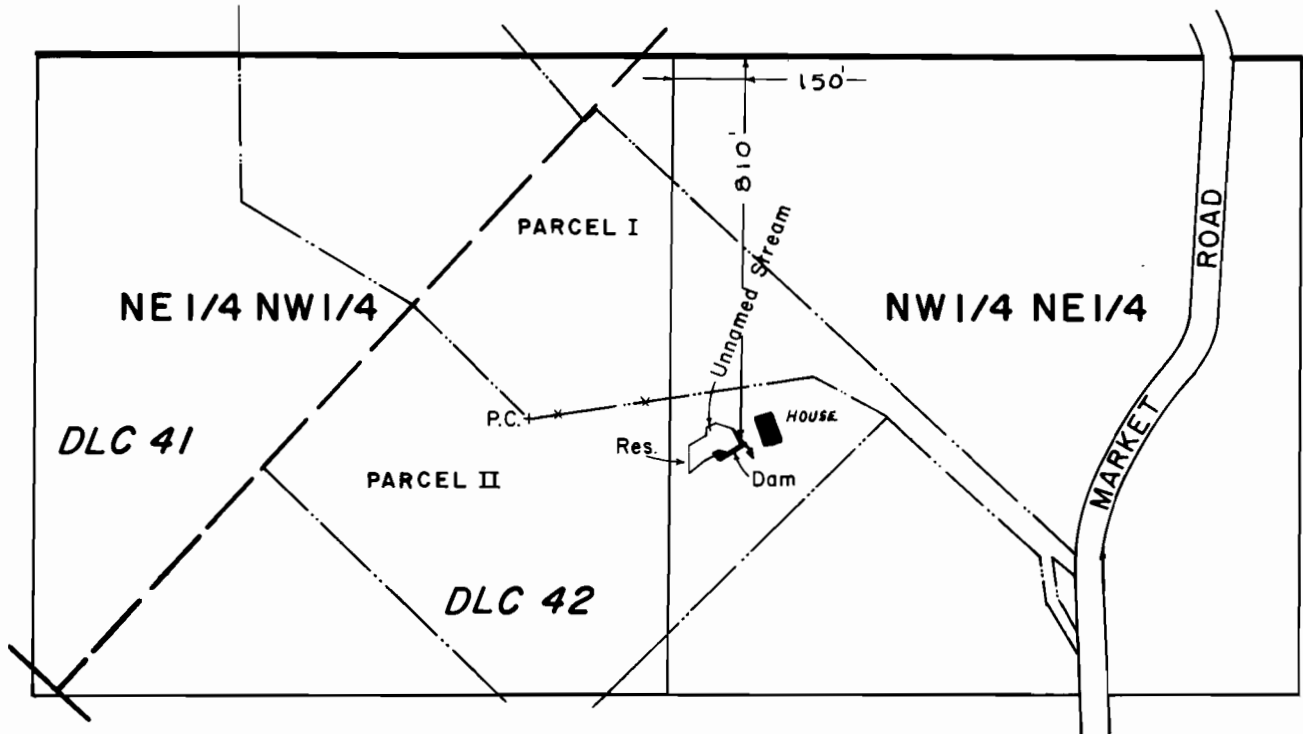

SCALE: 1" = 400'

FINAL PROOF SURVEY UNDER

R-69021

R-10825

Application No. 69022. Permit No. 49976....

IN NAME OF

ROBERT JAMES LOFGREN

Surveyed April 1 91 by R. W. KLASSEN
MAY 15 1990, by T. M. WARREN

6-15-90

PTS

REVISED 2/93 RWK