


RECEIVED

T. 13 S., R. 11 W., W.M.

APR 24 1997

WATER RESOURCES DEPT
SALEM, OREGON

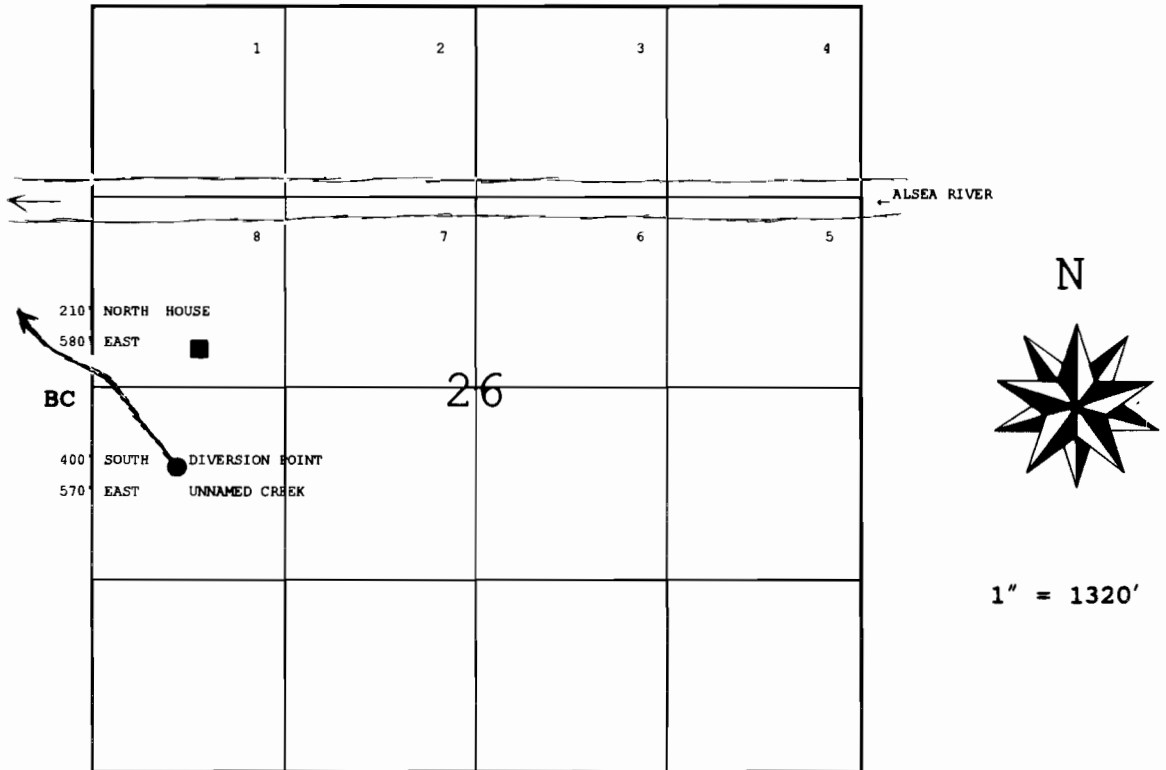

FINAL PROOF MAP

UNDER
APPLICATION S-74026 PERMIT 52075

FOR
BUCKLEY DOMESTIC WATER DEVELOPMENT

IN NAME OF
BRUCE A. AND CHERYL A. BUCKLEY

APRIL 20, 1997

Robert W. Dahl
 RLS, CWRE
 12/31/97

Expiration Date
12/31/97

THE PURPOSE OF THIS MAP IS FOR IDENTIFYING THE LOCATION OF THE WATER RIGHT ONLY AND IS NOT INTENDED TO PROVIDE LEGAL DIMENSIONS OR LOCATION OF PROPERTY OWNERSHIP LINES.

WRE - OREGON

BRUCE A. & CHERYL A. BUCKLEY
 P.O. BOX 535
 WALDPOR, OREGON 97394
 AGREEMENT DATED: APRIL 14, 1994

EXECUTED BY:
 ROBERT W. DAHL, RLS, CWRE
 P.O. BOX 1374
 WALDPOR, OREGON 97394