


T. 11S., R. 40E., W.M.

REC-161

JUN 10 1998

WATER RIGHTS
SALMON RIVER

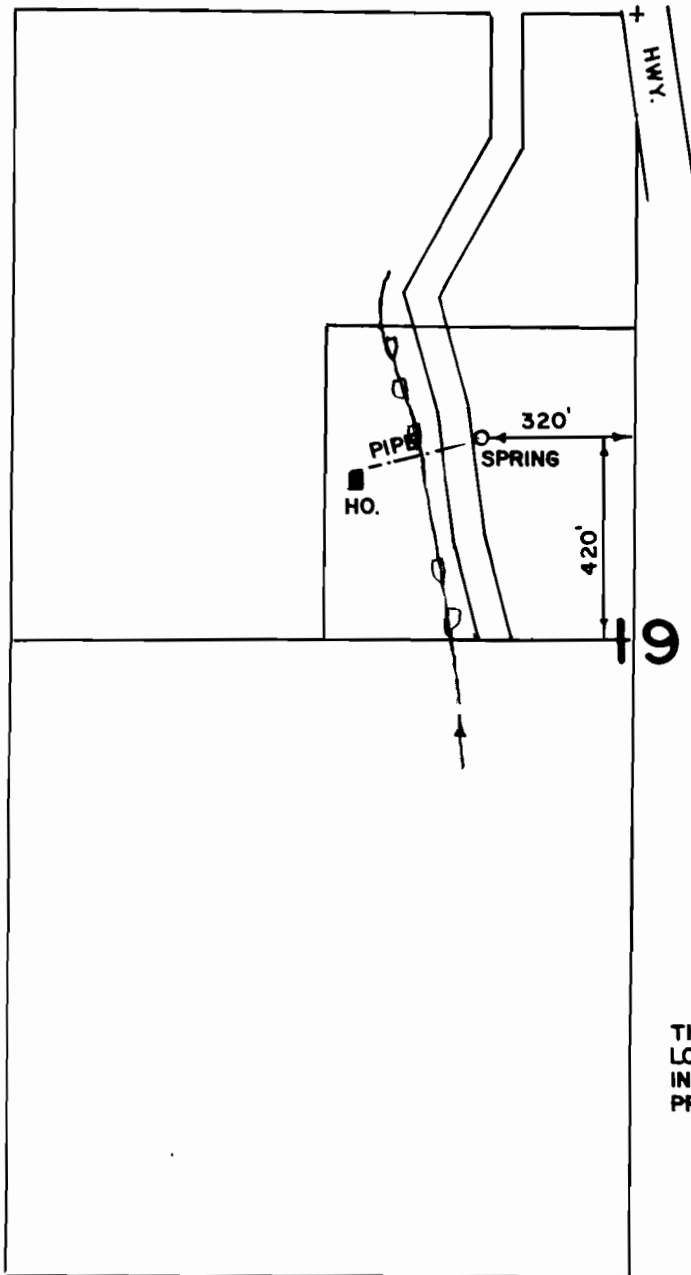

SCALE 1" = 400'

THE PURPOSE OF THIS MAP IS FOR IDENTIFYING THE LOCATION OF THE WATER RIGHT ONLY AND IS NOT INTENDED TO PROVIDE LEGAL DIMENSIONS OF PROPERTY OWNERSHIP LINES

FINAL PROOF SURVEY

APPL. 74304

PER. 52887

IN NAME OF

Donald & Lynn

Christensen

Surveyed June 26, 1998

