

**FINAL PROOF
 WATER RIGHTS MAP
 UNDER
 PERMIT 53467
 APPLICATION NO S-83607**


RECEIVED
 JUL 1 8 2003
 WATER RESOURCES DEPT.
 SALEM, OREGON

18-12-35-3-2, T.L. 3100
 NW 1/4, SW 1/4, SEC 35, T18S, R12W, W.M.
 LANE COUNTY, OREGON

FOR: HEINZ AND LEIGH ANN BEIERLING
 AND ELSE BEIERLING
 2674 RIVERWALK LOOP
 EUGENE, OREGON 97401

PREPARED BY: WOBBE & ASSOCIATES, INC.
 510 KINGWOOD ST. / P.O. BOX 3093
 FLORENCE, OR 97439
 DATE: JUNE 27, 2003

THIS MAP IS FOR THE PURPOSE
 OF IDENTIFYING THE LOCATION
 OF THE WATER RIGHT ONLY.
 THERE IS NO INTENT TO PROVIDE
 DIMENSIONS OR LOCATION OF
 PROPERTY OWNERSHIP LINES.

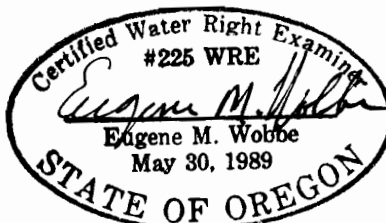

1"=400'