


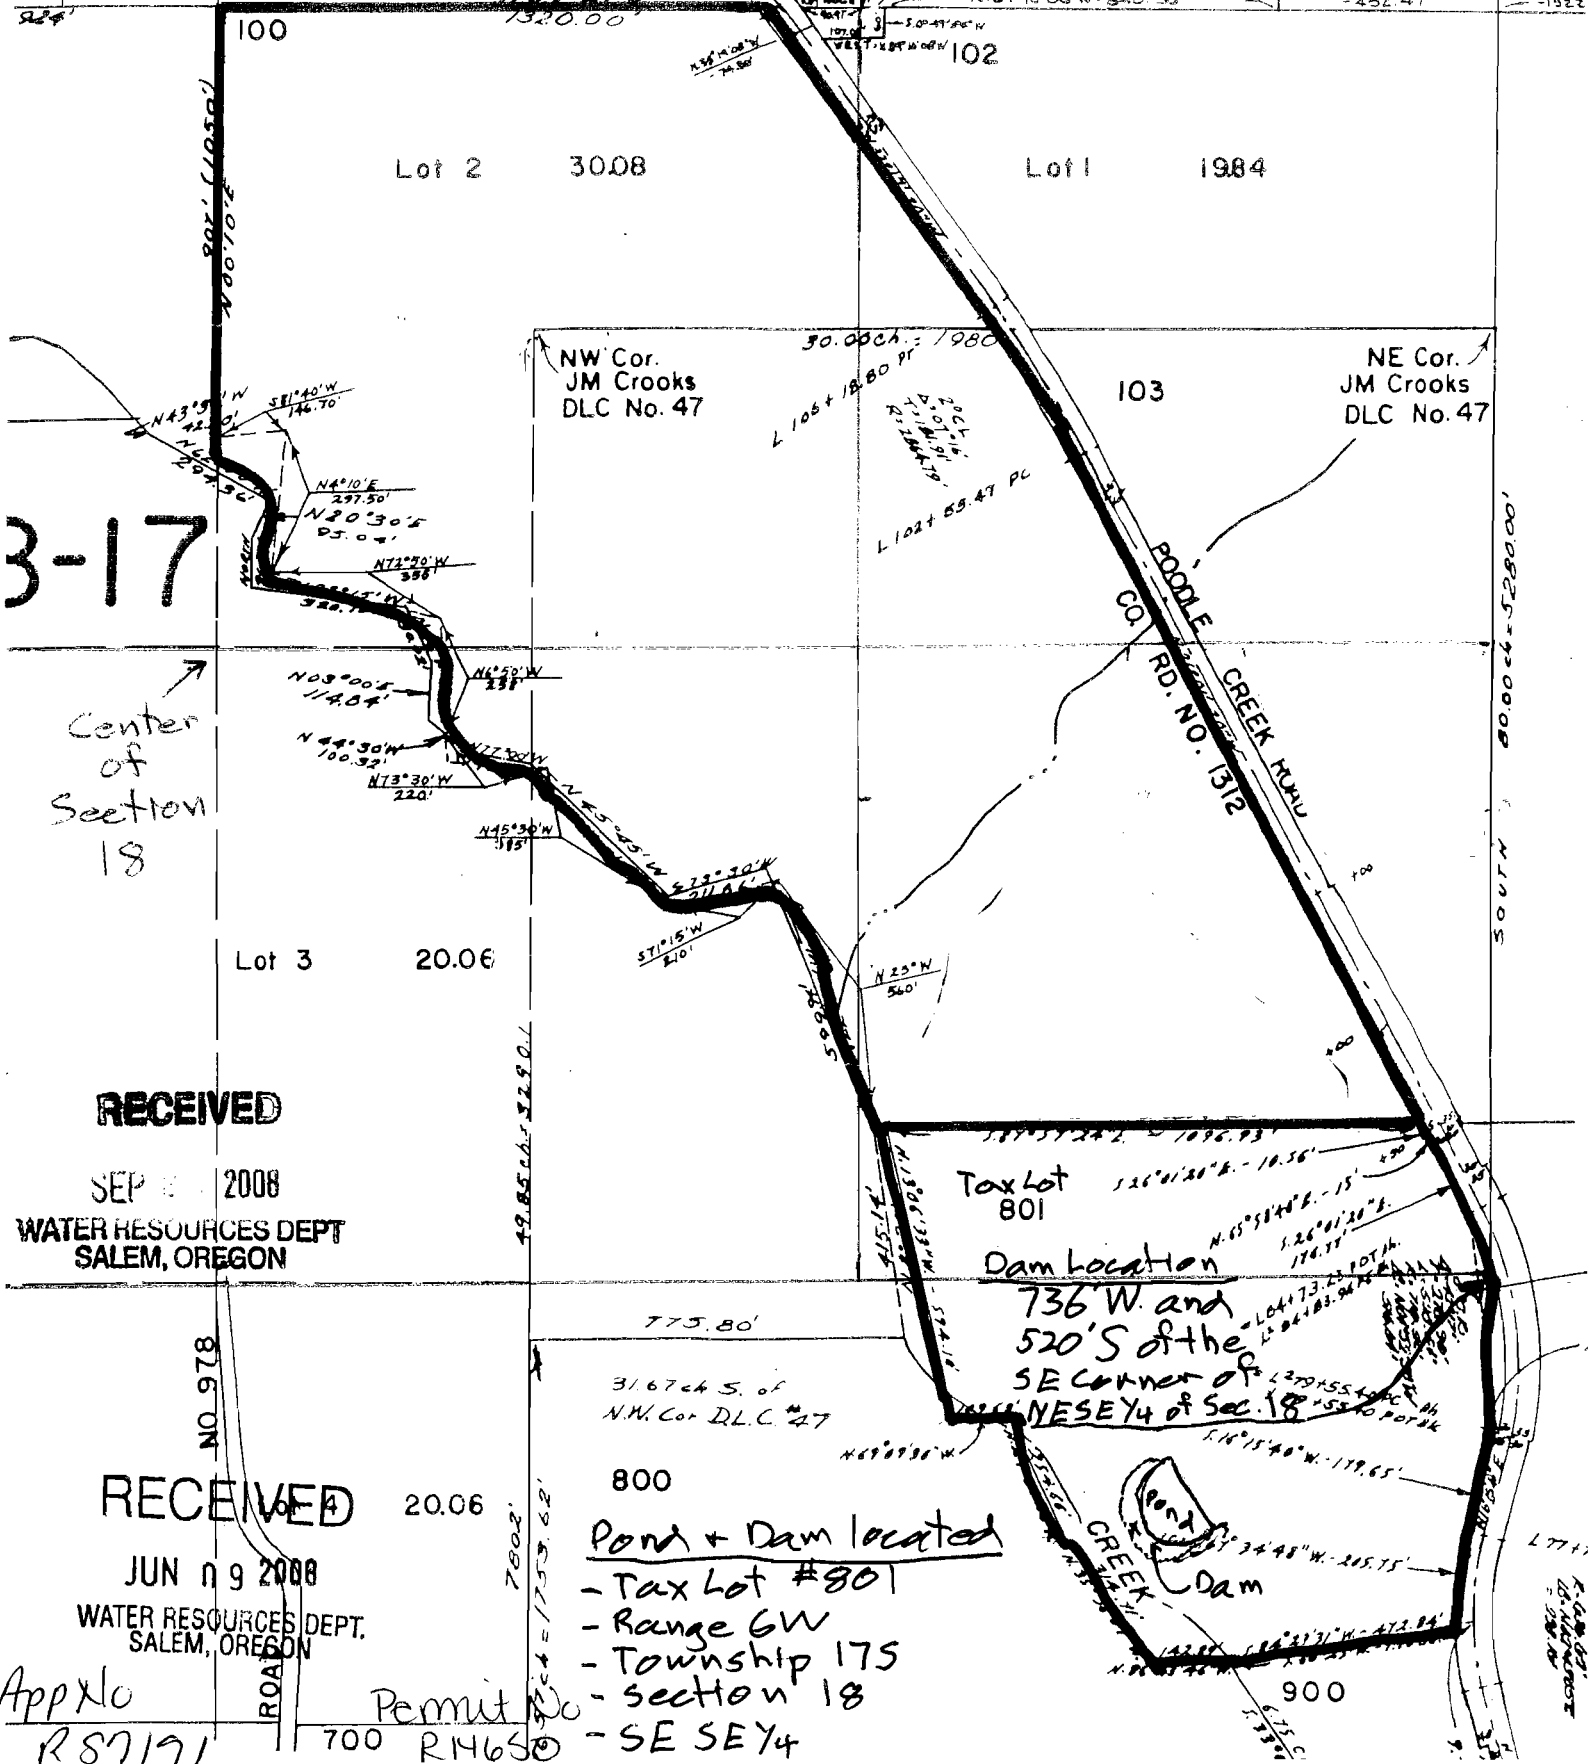

1" = 400'

Oak Pond LLC
Jack Gray
89762 Puddle Creek Rd
Noti, OR 97461



3-17

Center
of
Section
18

RECEIVED

SEP 2 2008

WATER RESOURCES DEPT
SALEM, OREGON

RECEIVED

JUN 19 2008

WATER RESOURCES DEPT.
SALEM, OREGON

App No

R87191

Permit No

700 RH650

800
Pond + Dam located
- Tax Lot #801
- Range 6W
- Township 17S
- Section 18
- SE SE 1/4

Tax Lot
801

Dam Location

736' W and
520' S of the
SE corner of
NE SE 1/4 of Sec. 18

