


Needham Reservoir Application Map

Township 3 South, Range 40 East, WM

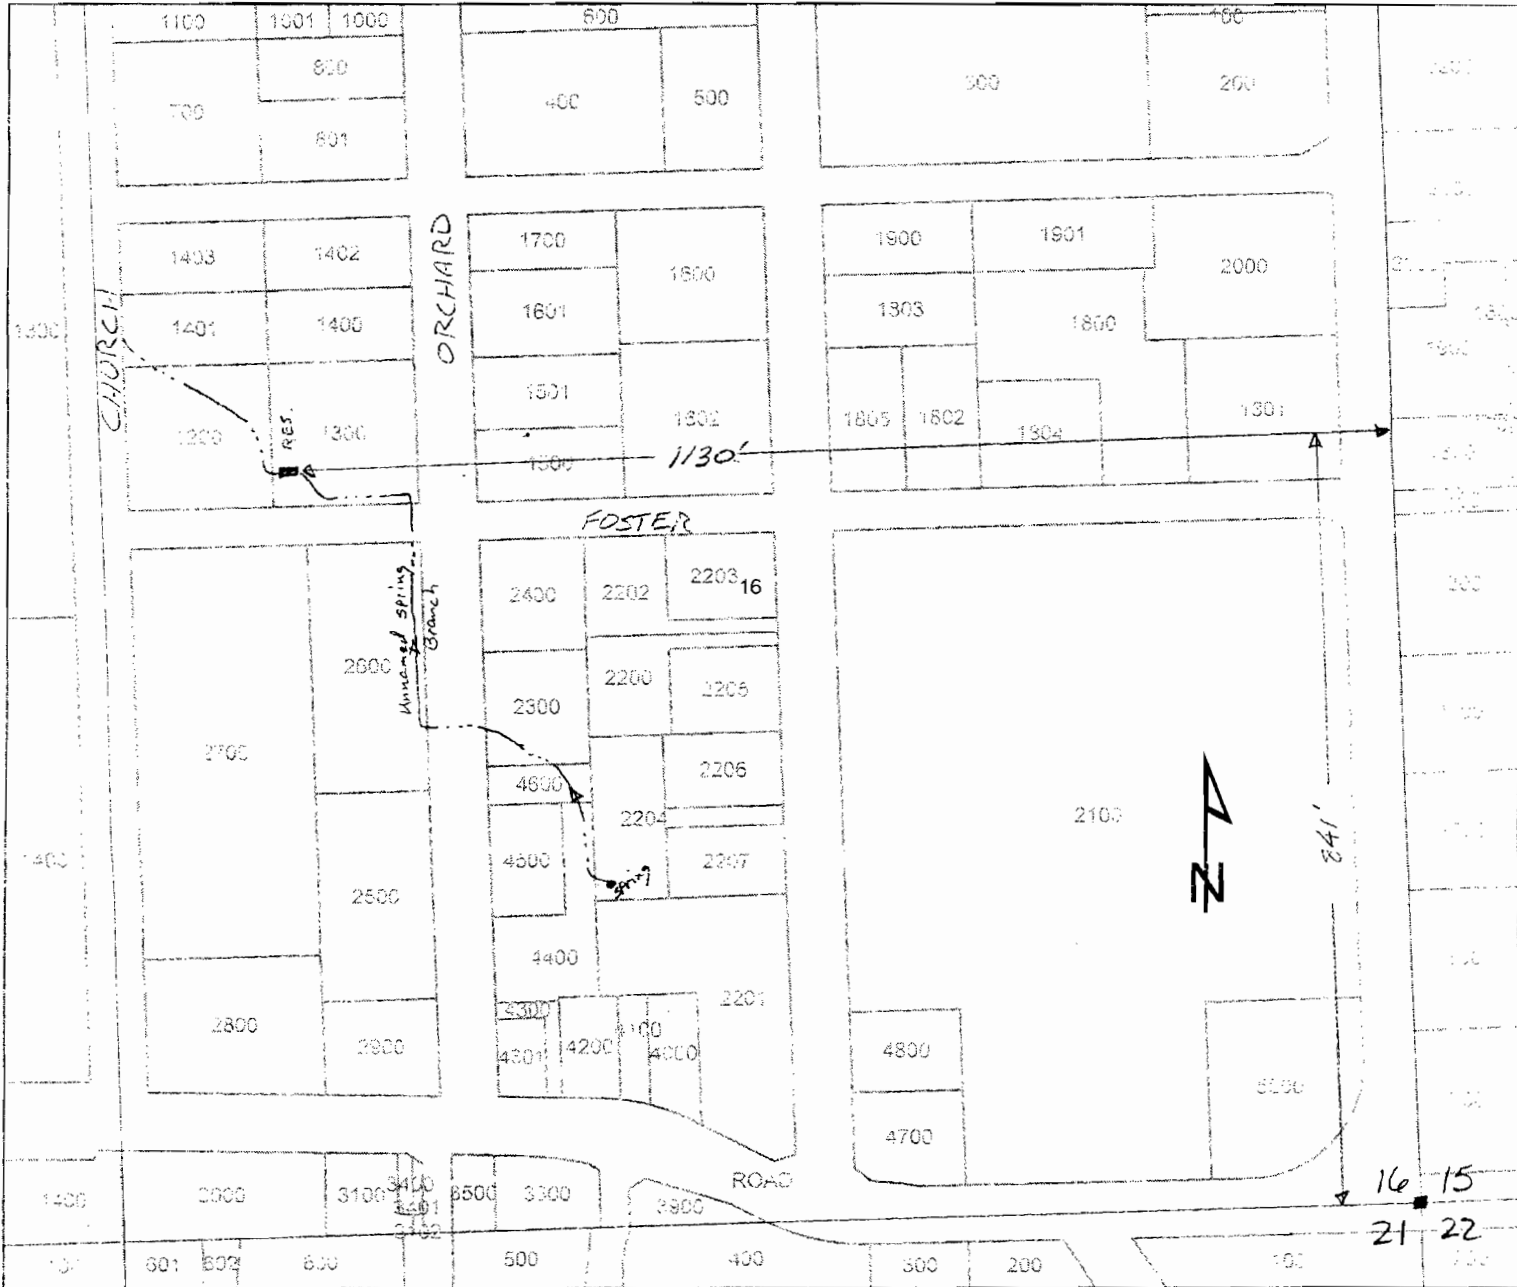

1 inch equals 200 feet

App no R 86912 permit no R 14561

RECEIVED

JUN 25 2007

WATER RESOURCES DEPT
SALEM, OREGON