
RECEIVED
APR 07 2008
WATER RESOURCES DEPT
SALEM, OREGON



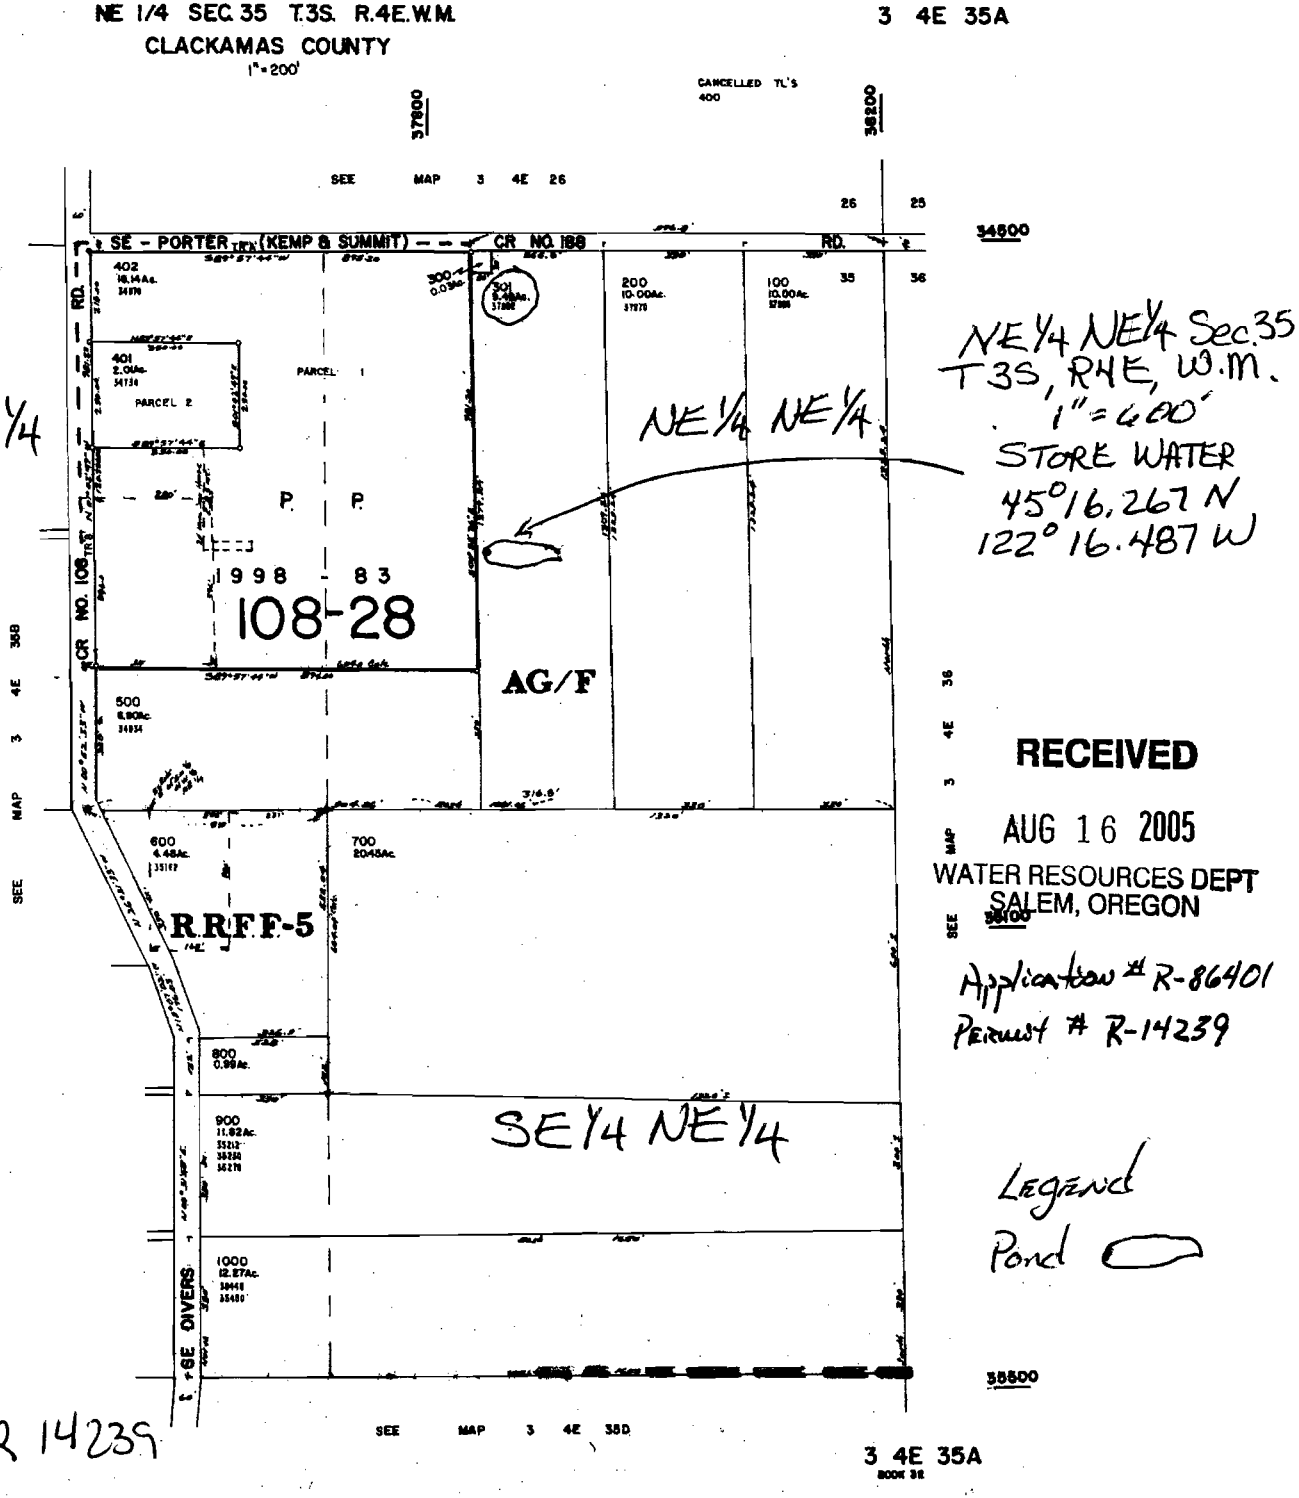


RECEIVED
AUG 16 2005
WATER RESOURCES DEPT
SALEM, OREGON

Application # R-86401
Permit # R-14239

App No R 86401 Permit No R 14239