


CLAIM OF BENEFICIAL USE MAP IN THE NAME OF EDWARD J. COOLEY

PERMIT 46290

TRANSFER T-8568

SECTION 13, TOWNSHIP 23 SOUTH, RANGE 8 WEST, W.M.

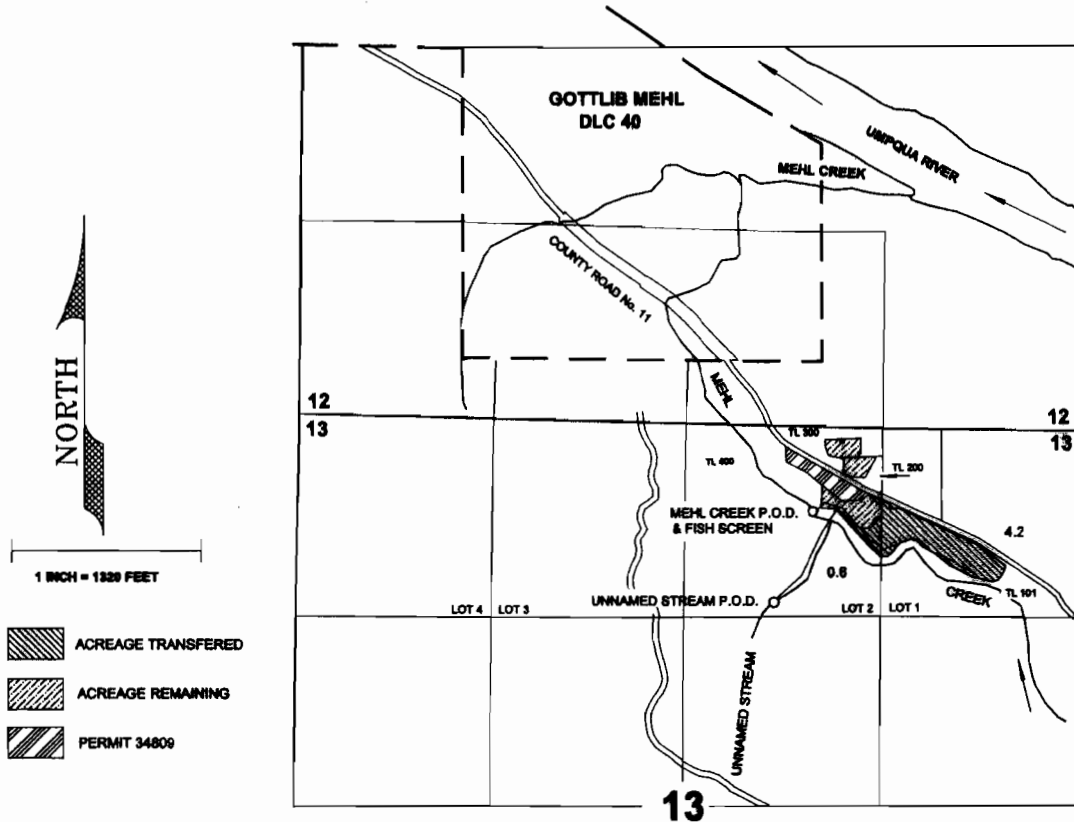

THE POINTS OF DIVERSION ARE LOCATED AS FOLLOWS:

MEHL CREEK: 620 FEET SOUTH AND 860 FEET EAST


UNNAMED STREAM: 1250 FEET SOUTH AND 600 FEET EAST

BOTH FROM THE NORTH QUARTER CORNER OF SECTION 13 AND WITHIN THE NW¼ NE¼ (LOT 2) OF SECTION 13, TOWNSHIP 23 SOUTH, RANGE 8 WEST, W.M.; DOUGLAS COUNTY.

RECEIVED

OCT 06 2008

WATER RESOURCES DEPT
SALEM, OREGON

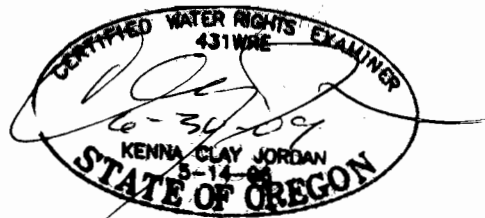

THE PURPOSE OF THIS MAP IS TO IDENTIFY THE LOCATION OF THE WATER RIGHT. IT IS NOT INTENDED TO PROVIDE INFORMATION RELATIVE TO THE LOCATION OF PROPERTY OWNERSHIP BOUNDARY LINES.

JORDAN ENGINEERING
460 JORDAN LANE
ROSEBURG, OR 97470
(541) 673-1931

REVISED 9-30-08