

# CLAIM OF BENEFICIAL USE FINAL PROOF MAP

Located in the NE $\frac{1}{4}$  SE $\frac{1}{4}$  of Section 31,  
Township 27 South, Range 13 West, W.M.  
Coos County, Oregon  
Application # S-77750 Permit #52859

**RECEIVED**

OCT 12 1998

WATER RESOURCES DEPT.  
SALEM, OREGON

NE1/16

Sec. 31  
Sec. 32

### Legend

- Pipe
- Creek
- Driveway
- POD
- House
- POB
- Irrigated Area

NOTE: Lawn and garden to be irrigated by lawn sprinklers and garden hose.

NOTE: POD is 472' East and 40' South of the CE1/16 corner of S31.

C1/4

CE1/16

E1/4

Scale 1" = 400 Feet

NOTE: The Dam is located 182 feet South and 111 feet East of the CE 1/16 corner of S31.

Existing Dam

Reservoir  
6.61 Acres

POD

1" Diam. PVC Pipe (450')

Irrigated Area  
0.5 Acres


NE1/4 SE1/4

Unnamed Stream

North Bank  
Co. Rd.

Prepared For: Denise Allen  
Prepared By: Dennis Goude  
Surveyed: September 18, 1998

SE1/16

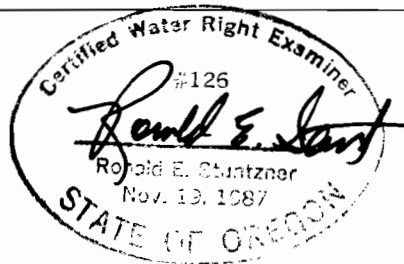

Stuntzner Engineering  
& Forestry

EXPIRES 06/30/00

EXAMINERS DISCLAIMER STATEMENT

The preparation of this map was for the purpose of identifying the location of the Water Right only and has no intent to provide dimensions or location of property ownership lines.

705 So. 4th Street  
P.O. Box 118  
Coos Bay, Oregon 97420  
Phone (541) 267-2872  
Fax (541) 267-0588