
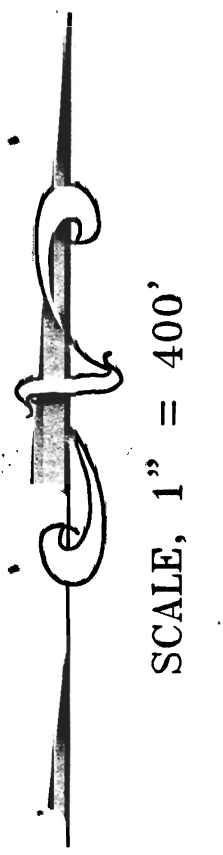


14 13

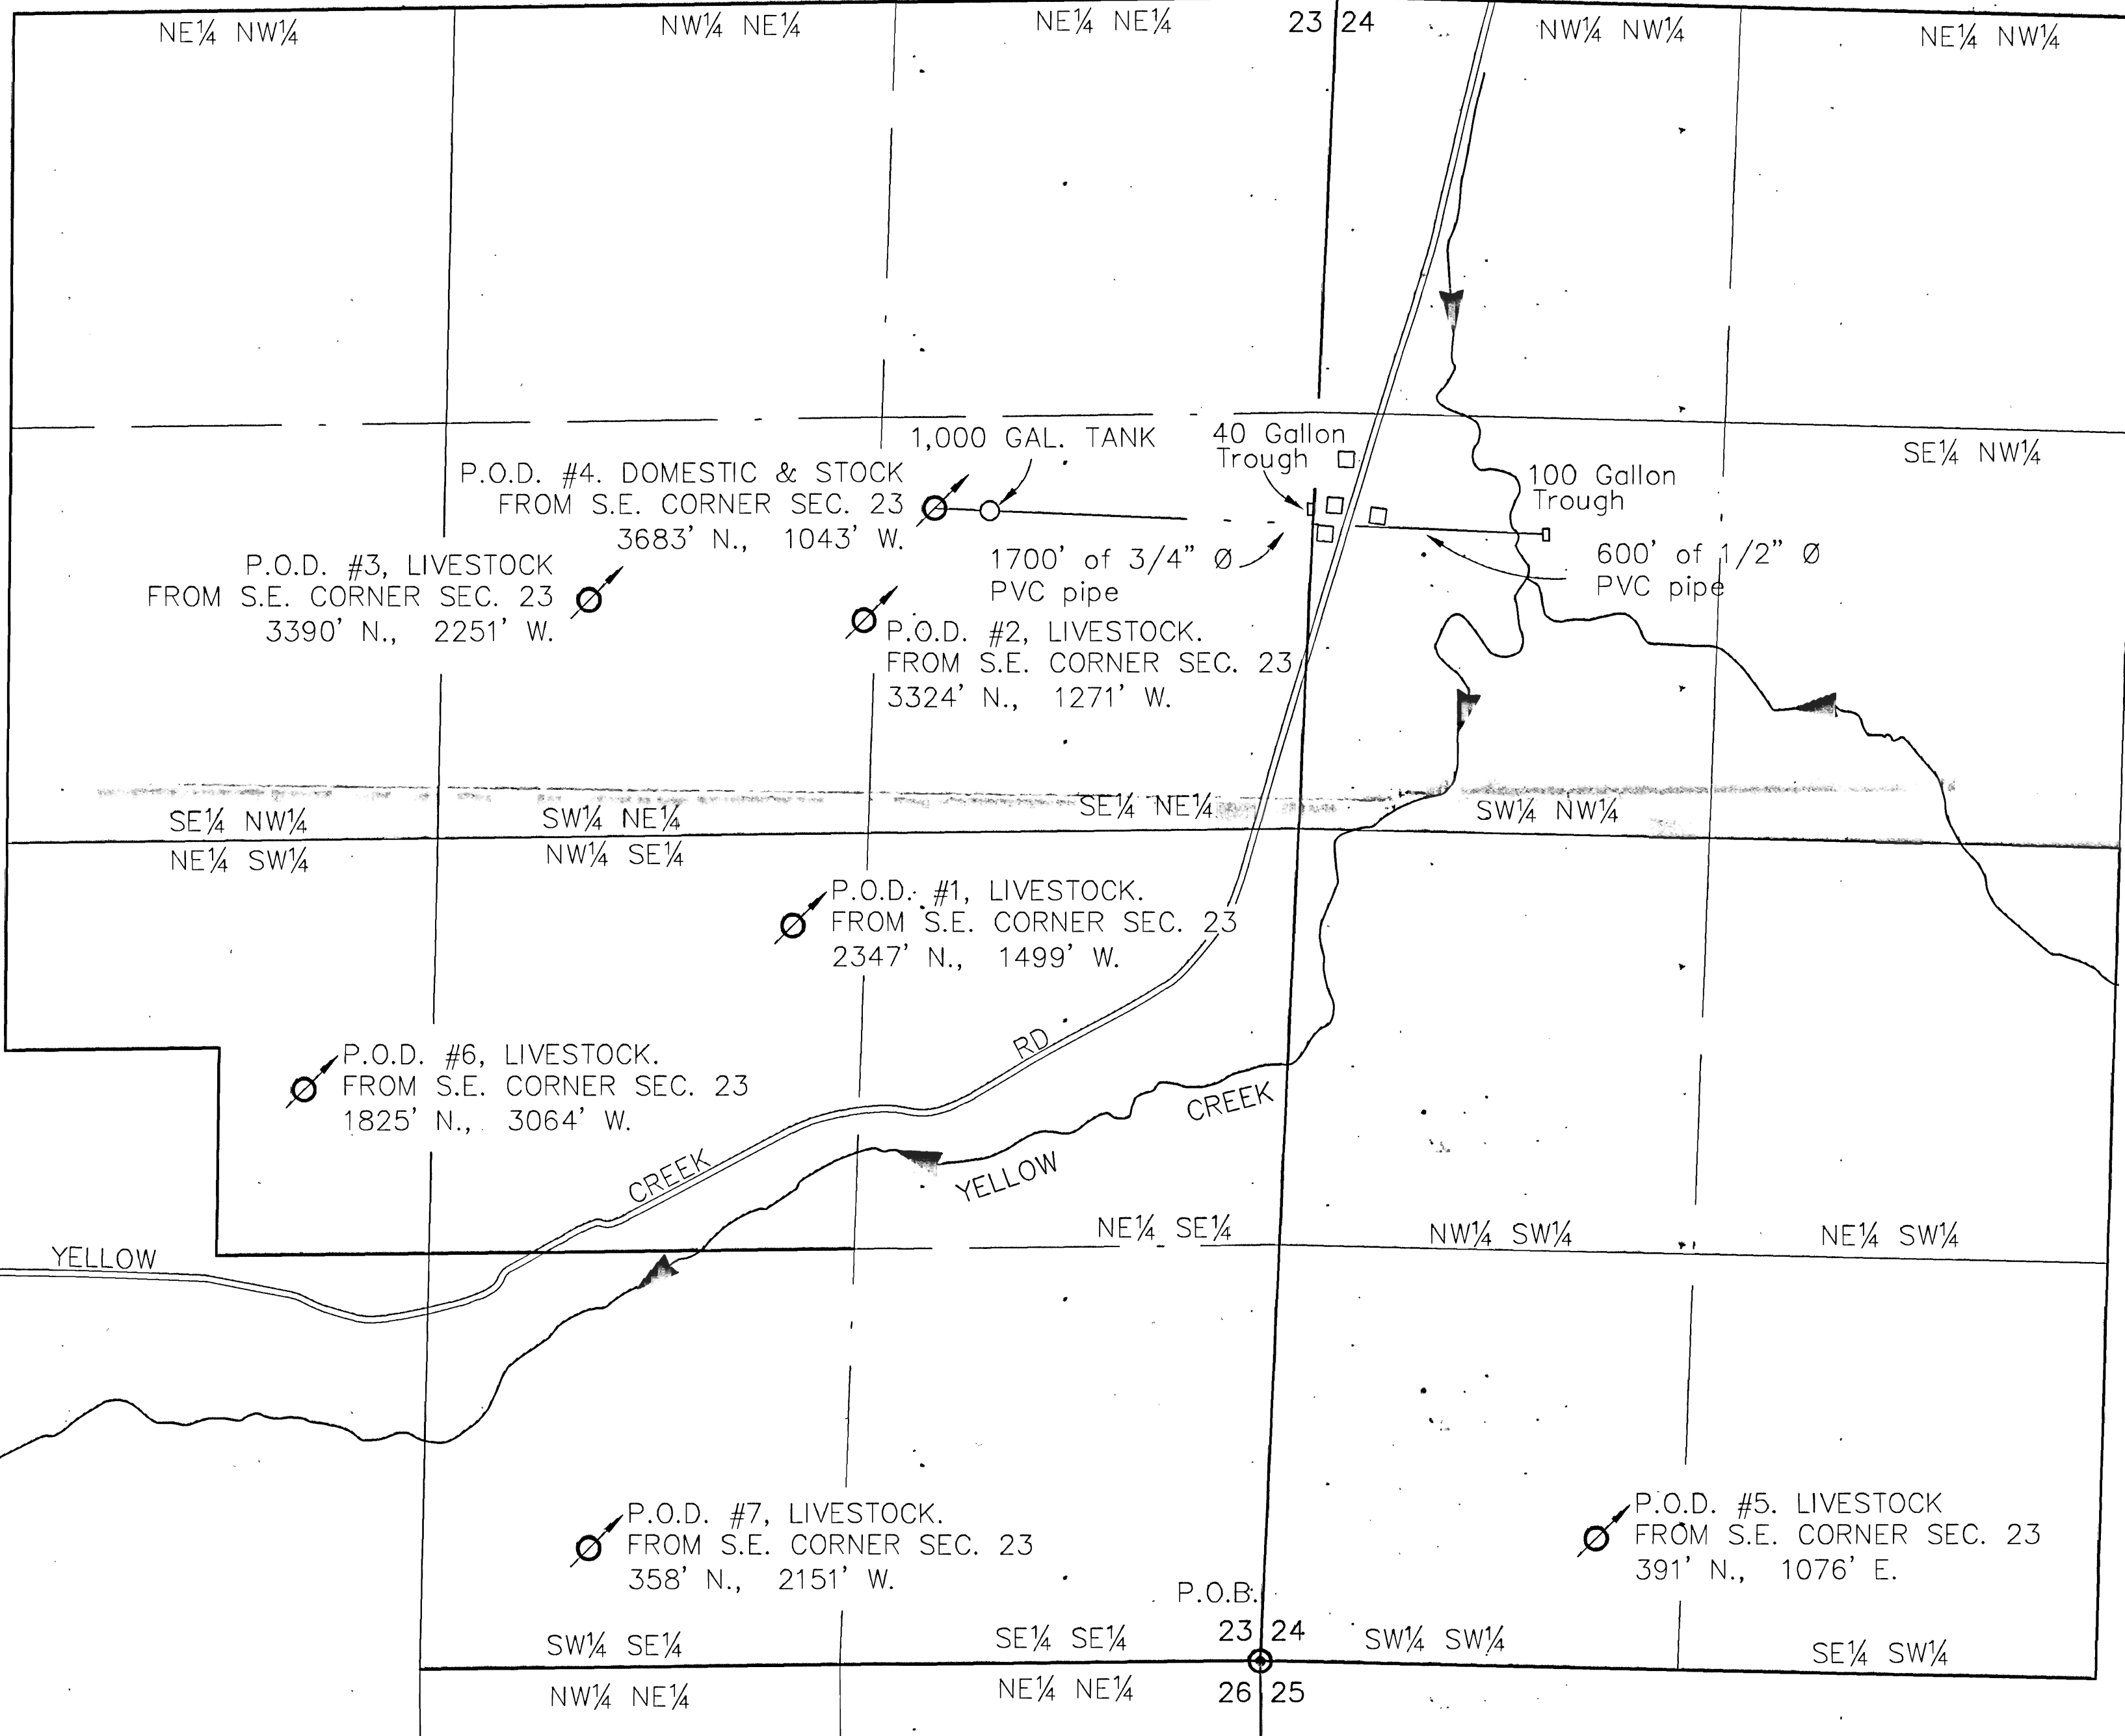

Prepared For: L. Monte & Beverly Lund
 Prepared By: Dennis Goude
 Surveyed: September 20, 1999

CLAIM OF BENEFICIAL USE FINAL PROOF MAP

Located in the SW 1/4 NE 1/4, SE 1/4 NE 1/4, NE 1/4 SW 1/4, NW 1/4 SE 1/4, SW 1/4 SE 1/4, of Section 23, SW 1/4 SW 1/4 of Section 24, NE 1/4 SE 1/4, of Section 26, Township 30 South, Range 12 West, W.M. Coos County, Oregon
 Application # S-73124 Permit #52100

NOTE:
 P.O.D.'s #1,2,3,5,6,7, & 8 are livestock watering troughs, P.O.D. #4 is domestic & livestock. P.O.D. #1 is an inspring device with 35' of 3/4" diameter PVC connecting to a 100 gallon Rubbermaid stock trough.
 P.O.D. #2 is an inspring device with 50' of 3/4" diameter PVC connecting to a 100 gallon Rubbermaid stock trough.
 P.O.D. #3 is an inspring device with 75' of 3/4" diameter PVC connecting to a 100 gallon Rubbermaid stock trough.
 P.O.D. #4 is a 3' x6' x30" concrete catch basin with 200' of 3/4" PVC connecting to a 1000 gallon storage tank, 1500' of 3/4" diameter PVC connect the storage tank to a 40 gallon stock tub and the residence. 600' of 1/2" diameter PVC run from the connection at the residence to a 100 gallon Rubbermaid stock trough.
 P.O.D. #5 is a rock catch basin with 50' of 1/2" diameter PVC connecting to a 40 gallon stock tub.
 P.O.D. #6 is an inspring device with 80' of 3/4" diameter PVC connecting to a 100 gallon Rubbermaid stock trough.
 P.O.D. #7 is a catch basin with 80' of 3/4" diameter PVC connecting to a 100 gallon Rubbermaid stock trough.
 P.O.D. #8 is a rock catch basin with 30' of 3/4" diameter PVC connecting to a 30 gallon Rubbermaid stock trough.

LEGEND
 P.O.D.
 P.O.B.
 BUILDINGS



RECEIVED
 SEP 30 1999
 WATER RESOURCES DEPT.
 SALEM, OREGON

EXAMINERS DISCLAIMER STATEMENT

The preparation of this map was for the purpose of identifying the location of the Water Right only and has no intent to provide dimensions or location of property ownership lines.

Stuntzner Engineering & Forestry, L.L.C.
 ENGINEERING * LAND SURVEYING * FORESTRY PLANNING * WATER RIGHTS
 705 South 4th St. Phone: (541) 267-2872
 Post Office Box 118 Coos Bay, Oregon 97420 Fax: (541) 267-0588

Drawn By: Dennis Goude	Date:
Checked By: Tom Hoshall	Drawing No.: 99-219
Designed By:	Revised: September 23, 1999
Job Name: Lund Final Proof	Sheet 1 of 1